


MUNICIPAL UTILITY DISTRICT NO. 191  
HARGRAVE ROAD  
PROPOSED SANITARY SEWER AND WATER EXTENSION  
HARRIS COUNTY, TEXAS

REVISIONS

ISSUED FOR PRELIMINARY REVIEW	02/26/04
ISSUED FOR FINAL REVIEW	03/17/05
-	-
-	-
DRAWING INDEX

1 OF 10	COVER SHEET
2 OF 10	GENERAL NOTES
3 OF 10	OVERALL LAYOUT
4 OF 10	PLAN & PROFILE
5 OF 10	PLAN & PROFILE
6 OF 10	PLAN & PROFILE
7 OF 10	PLAN & PROFILE
8 OF 10	PLAN & PROFILE
9 OF 10	DETAIL SHEET
10 OF 10	DETAIL SHEET

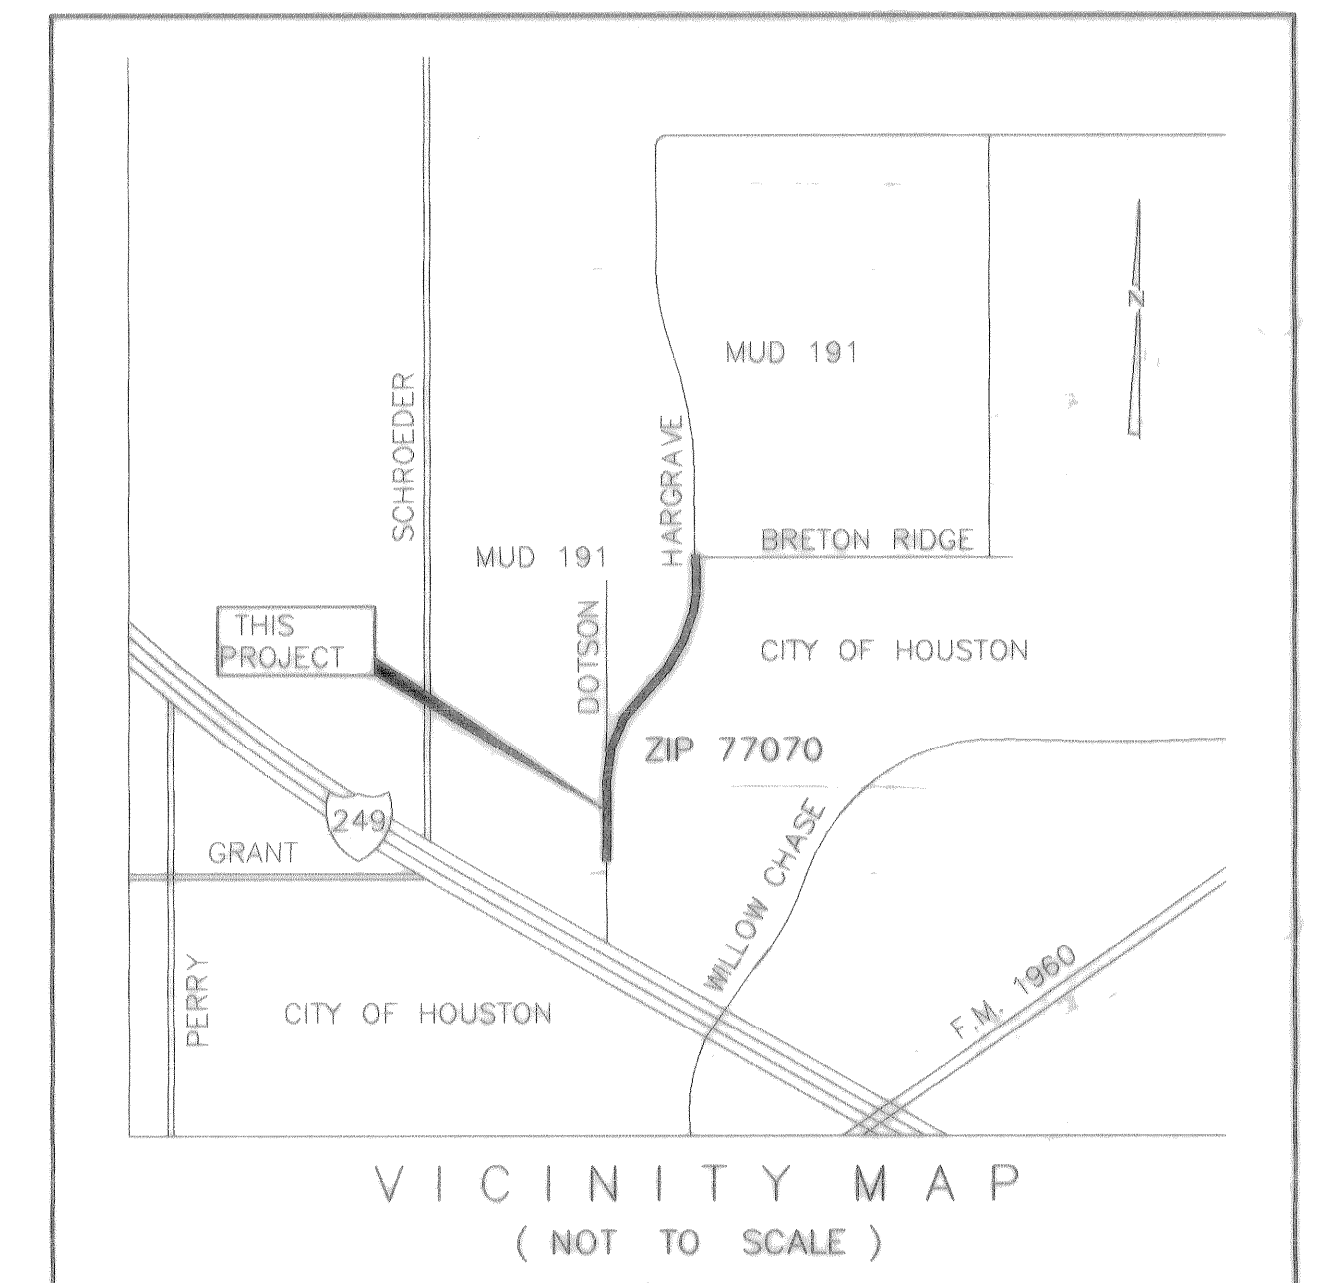

KEY MAP #369-H GIMMS 4966C

AS-ABUILTS BY : DEEP SOUTH CONSTRUCTION 3-16-07

# ASPEN CIVIL DESIGN

(832) 607-3551  
(281) 265-3551 Fax

14019 S.W. Freeway, Suite 301-278  
Sugar Land, Texas 77478

<b>MICHAEL J. LEWIS</b> <small>14019 S.W. Freeway, Suite 301-278                  Sugar Land, Texas 77478                  (832) 607-3551                  (281) 265-3551 Fax</small>		
SURVEYED BY: J. WEEKS    FB NO. <i>41467</i>		
WATER	STORM WATER QUALITY	
WASTEWATER	TRAFFIC AND TRANSPORTATION	
STORM WATER	WATER PRODUCTION	
STREET & BRIDGE		
CITY ENGINEER		
DIRECTOR OF PUBLIC WORKS AND ENGINEERING		
SHEET NO 1 OF 10 SHEETS		