


TYPICAL SIGN MOUNT DETAIL
SCALE: N.T.S.

NOTES:

1. ALL STOP SIGNS TO BE SIZED AND PLACED AS SHOWN ON PLANS.
2. STREET NAME SIGNS TO BE INSTALLED AT INTERSECTION OF ALL STREETS.

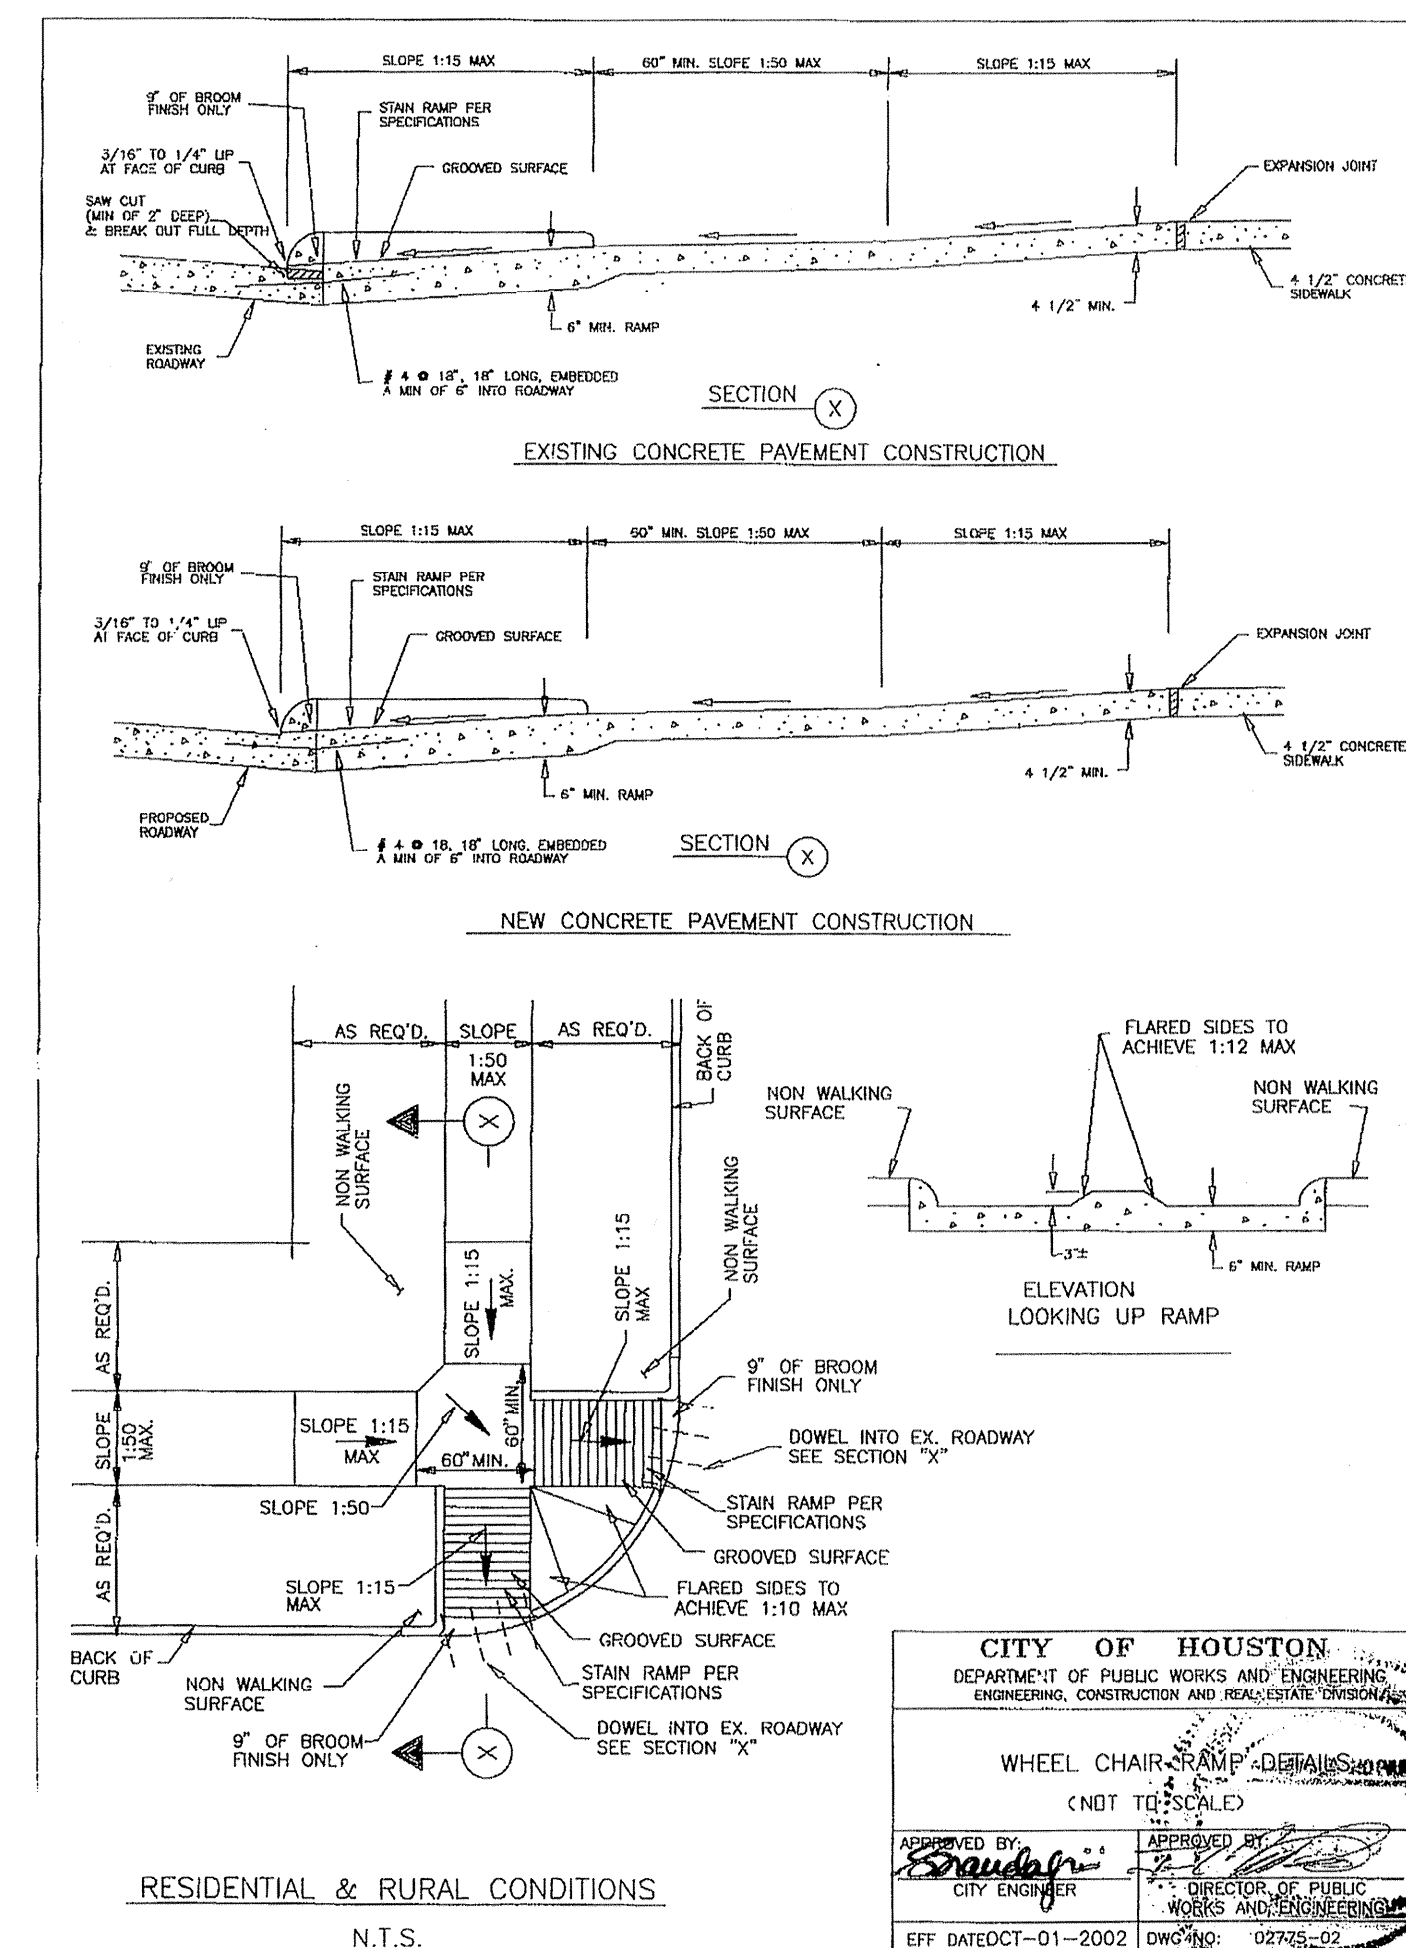

RESIDENTIAL & RURAL CONDITIONS
N.T.S.

CITY OF HOUSTON
DEPARTMENT OF PUBLIC WORKS AND ENGINEERING
ENGINEERING, CONSTRUCTION AND RECONSTRUCTION DIVISION

WHEEL CHAIR RAMP DETAILS (NOT TO SCALE)

APPROVED BY: [Signature]
CITY ENGINEER

APPROVED BY: [Signature]
DIRECTOR OF PUBLIC WORKS AND ENGINEERING

EFF. DATE: 01-2002 DWG. NO. 02745-02

HARRIS COUNTY MUD 191
VILLAS at WILLOWBROOK

UTILITIES
WHEELCHAIR RAMP &
VARIOUS DETAILS

| | | |
|--------------|------------|---------|
| WATER | WASTEWATER | TRAFFIC |
| ST. & BRIDGE | STORMWATER | SWD |

FILE NO:
DRAWING SCALE:
N/A
VERT: HORZ:
SHEET No: 19 OF 24



PROVIDENT CONSULTING, INC.
1405 ALLSTON ST.
HOUSTON, TEXAS 77008
(713)802-1019

PC
PROVIDENT CONSULTING, INC.

