


BEDDING FOR HDPE PIPE

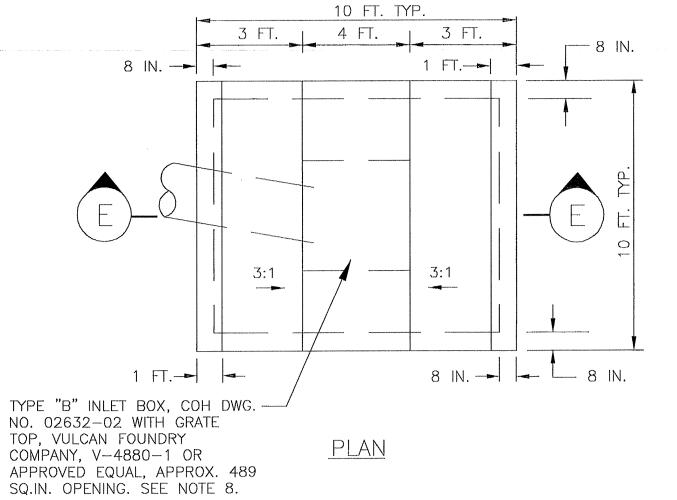

10 FT. TYP. MATCH TOP OF CONCRETE WITH 3 FT. 4 FT. 3 FT. NATURAL GROUND 2 FT. 6 IN.— WALLS AND FLOOR SHALL BE

8 INCH CONCRETE BRICK

URBAN BACKSLOPE (24 INCH ONLY)

INTERCEPTOR STRUCTURE DETAIL NOTES:

METAL PIPE (CMP) IN ACCORDANCE WITH SPECIFICATION SECTION 02642-CORRUGATED METAL PIPE, HIGH DENSITY POLYETHLENE (HDPE) PIPE IN ACCORDANCE WITH SPECIICATION SECTION 2505-HIGH DENSITY POLYETHYLENE, OR APPROVED EQUAL

2. PROVIDE AND PLACE CEMENT STABILIZED SAND IN ACCORDANCE WITH SPECIFICATION

SECTION 02321-CEMENT STABILIZED SAND.

3. EXCAVATION, FILL AND BACKFILL FOR STORM SEWER OUTFALLS SHALL BE IN ACCORDANCE WITH SPECIFICATION SECTION -02316-STRUCTURAL EXCAVATING AND BACKFILLING. 4. CONCRETE SHALL BE STRUCTURAL CONCRETE IN ACCORDANCE WITH SPECIFICATION

SECTION 03310-CONCRETE.

5. INTERCEPTOR STRUCTURES: a ADJUST LENGTH AND WIDTH IN FIELD AS NECESSARY.

b. 2-FEET DEEP X 8-INCH WIDE TOE ALL AROUND THE STRUCTURE. c. STEEL REINFORCING-#4 BARS (GRADE 40) AT 12 INCHES ON CENTER EACH

d. ANY INTERCEPTOR OUTFALL PIPE LARGER THAN MAXIMUM SIZE INDICATED

REQUIRES A SEPARATE DETAIL. e. MATCH TOP OF CONCRETE WITH NATURAL GROUND.

6. SET FLOWLINE OF OUTFALL PIPES 1 FOOT ABOVE CHANNEL FLOWLINE OR 1 FOOT ABOVE NORMAL WATER SURFACE ELEVATION.

7. SEE CONCRETE CHANNEL LINING DETAIL SHEET FOR CMP OR HDPE OUTFALL DETAILS


TROUGH CONCRETE CHANNEL LINING. 8. CONCRETE PAD AROUND TYPE "B" INLET: PAID FOR AS CONCRETE INTERCEPTOR

STRUCTURE PER UNIT PRICE SCHEDULE. 9. BACKSLOPE SWALE AND INTERCEPTOR STRUCTURE ELEVATIONS AND LOCATIONS SHOWN ON

THE PLANS ARE APPROXIMATE. FINAL ELEVATIONS AND LOCATIONS SHALL BE FIELD

VERIFIED BY THE ENGINEER PRIOR TO INSTALLATION. 10. MINIMUM TRENCH WIDTH SHALL BE NOT LESS THAN THE GREATER OF WIDTH OF THE PIPE OUTSIDE DIAMETER PLUS 16 IN. OR THE PIPE OUTSIDE DIAMETER TIMES 1.25 PLUS 12 IN. (SEE ASTM D2321)

THIS DETAIL SHEET HAS BEEN PREPARED FOR USE ON HCFCD PROJECTS OR PROJECTS TO BE MAINTAINED BY THE HCFCD WHEN COMPLETED BY OTHERS. AN ENGINEER WHO INCORPORATES THE DETAILS ON THIS SHEET BECOMES RESPONSIBLE FOR ITS USE IN THE END PRODUCT IN ACCORDANCE WITH RULE \$137.33 (b) AND (c) OF THE TEXAS STATE BOARD OF REGISTRATION FOR PROFÈSSIONAL ENGINEERS.

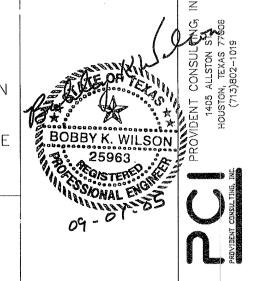


WILLOWBROOK

W V

#

PROJE

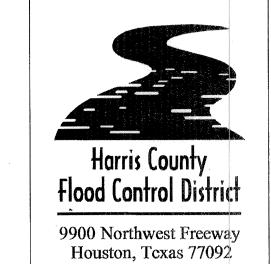

DATE: 10-5-04 SCALE: NTS

SHEET NUMBER

