



# CONSTRUCTION PLANS TO SERVICE HARRIS COUNTY MUNICIPAL UTILITY DISTRICT NO. 191 FOR PROP. 8" WATER LINE AND 8" SANITARY SEWER ALONG HARGRAVE ROAD & S.H. 249 HOUSTON, TEXAS 77070 JANUARY 2016

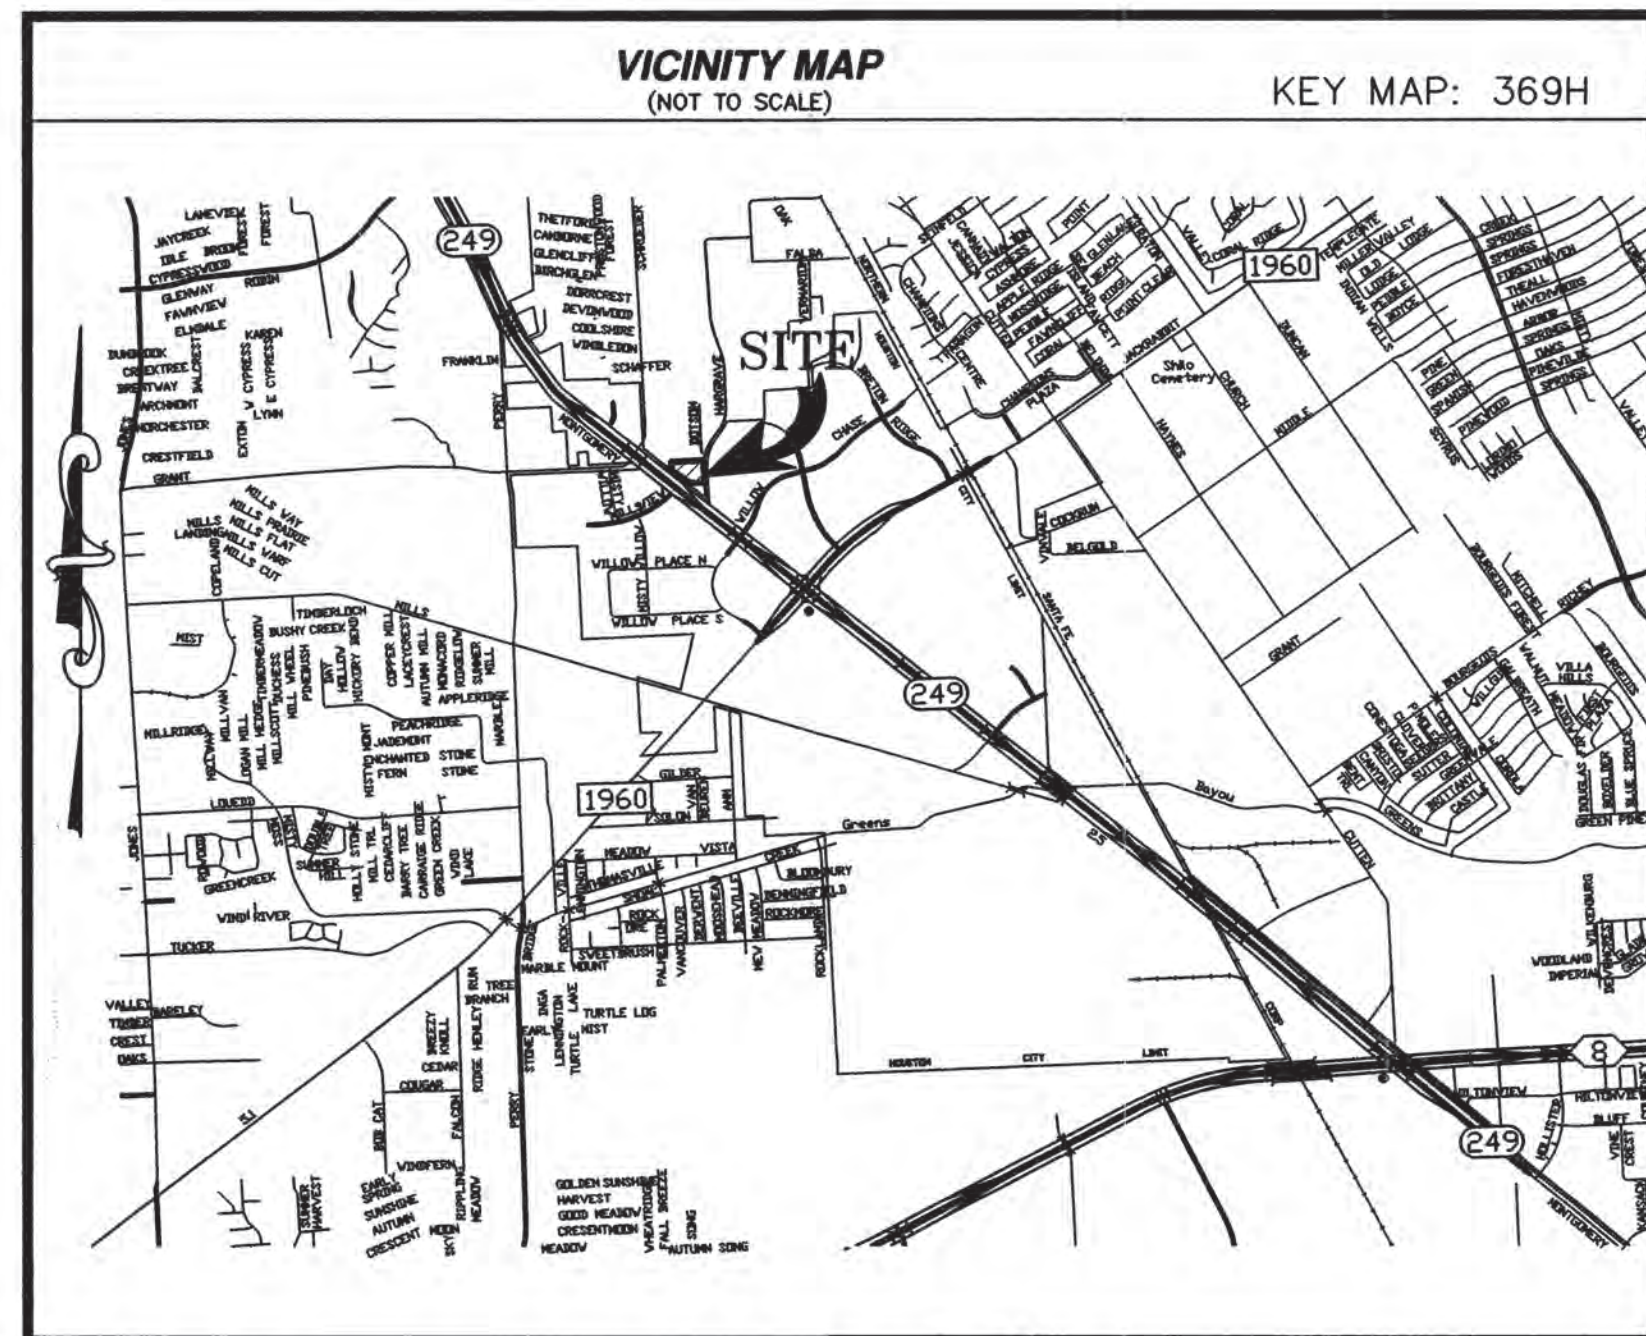

ZIP CODE: 77070 KEY MAP: 369H  
GIMS MAP: 4966C  
CENTERPOINT ENERGY ID#: 1403593937  
AT&T TEXAS LOG # 060915KT13

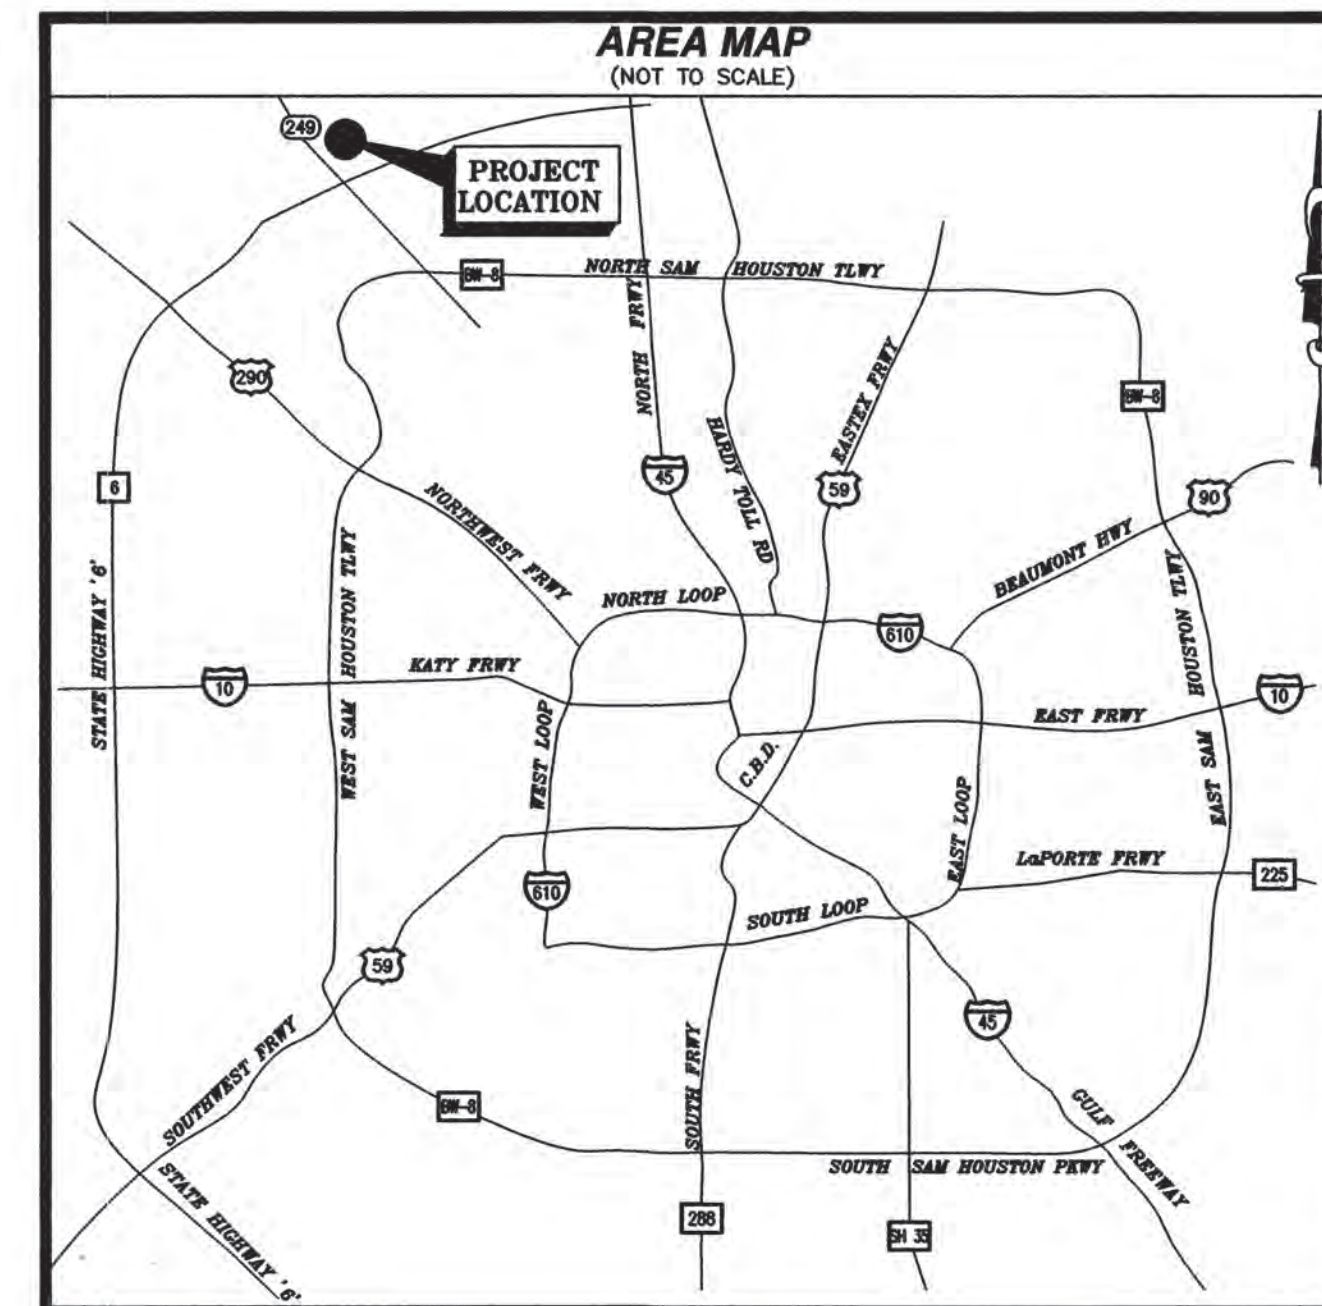

ACCORDING TO MAP NO. 48201C0435M OF THE FEDERAL EMERGENCY MANAGEMENT AGENCY'S FLOOD INSURANCE RATE MAPS FOR HARRIS COUNTY AND INCORPORATED AREAS, DATED OCTOBER 16, 2013, THE SUBJECT TRACT IS SITUATED WITHIN: ZONE X-UNSHADED

**INDEX OF DRAWINGS**

SHEET NO.	DESCRIPTION
1	COVER SHEET
2	CONSTRUCTION NOTES
3	HARRIS COUNTY EXPRESS REVIEW SHEET
4	OVERALL WATER & SANITARY LAYOUT
5	STORMWATER POLLUTION PREVENTION PLAN
6	PLAN & PROFILE: HARGRAVE ROAD-BASELINE #1: 0+00 TO END
7	PLAN & PROFILE: HARGRAVE ROAD-BASELINE #2 & BASELINE #3: 0+00 TO END
8	PLAN & PROFILE: S.H. 249-BASELINE #4: 0+00 TO END
9	WATERLINE CONSTRUCTION DETAILS
10	SANITARY SEWER CONSTRUCTION DETAILS
11	STORMWATER POLLUTION PREVENTION DETAILS

ONE CALL NOTIFICATION SYSTEM  
**CALL BEFORE YOU DIG!!**  
CALL AT LEAST 2 WORKING DAYS (48 HOURS) BEFORE YOU DIG:  
TEXAS811 (DIG TESS) (1-800-344-8377)  
OR  
LONE STAR NOTIFICATION CENTER (1-800-669-8344)

48 HOURS NOTICE PRIOR TO START OF CONSTRUCTION.

CONTRACTOR SHALL NOTIFY THE CITY OF HOUSTON, DEPARTMENT OF PUBLIC WORKS AND ENGINEERING, OCE 48 HOURS BEFORE STARTING WORK ON THIS PROJECT.  
TEL NO: 832-394-9098

**C.O.H. LOG#: 15-1136**  
**ILMS#: 15089701**

**48 HOUR NOTICE:**

CONTRACTOR SHALL NOTIFY HARRIS COUNTY PRIOR TO COMMENCING CONSTRUCTION AND/OR BACK-FILLING ANY UTILITIES.  
CONTRACTOR(S) TO CONTACT MARC BARBE WITH PUBLIC REVIEW DEPARTMENT @ (713-274-3823) OR (MARC.BARBE@HCPID.ORG).

*Chad Walker*  
HARRIS COUNTY MUD NO. 191 ENGINEER  
SIGNATURE VALID FOR ONE (1) YEAR  
DATE: 6/13/16

01/19/16

**HEIGHTS ENGINEERING LLC**  
CONSULTING ENGINEERS  
7324 SOUTHWEST FWY SUITE 995 HOUSTON, TX 77074  
PHONE: (713) 333-0393 FAX: (281) 274-9153  
www.HEIGHTSENGINEERING.com

**PROP. 8" WATER LINE & 8" SANITARY SEWER**  
ALONG HARGRAVE ROAD & S.H. 249  
TO SERVICE HARRIS COUNTY MUD #191  
HEIGHTS PROJ. NO: 14-190 DRAWING NO: 14190100  
SURVEYED BY: FB NO.:  
NOTE: CITY SIGNATURES VALID FOR ONE YEAR ONLY AFTER DATE OF SIGNATURES

**CITY OF HOUSTON**  
DEPARTMENT OF PUBLIC WORKS AND ENGINEERING

WATER	TRAFFIC & TRANSPORTATION
WASTEWATER	STORM WATER QUALITY
STORM	FACILITIES
STREET & BRIDGE	
CITY ENGINEER	FOR OFFICE OF HOUSTON ENGINEERING ONLY CITY DWG NO. 55439 CITY DRAWING NUMBER
DIRECTOR OF PUBLIC WORKS & ENGINEERING	

SHEET NO: 1 OF 11 **AS-BUILT**