

WARNING
OVERHEAD AND UNDERGROUND UTILITIES MAY EXIST IN THE VICINITY OF THIS PROJECT. LOCATIONS SHOWN FOR EXISTING UTILITIES ARE APPROXIMATE AND OTHER UTILITIES MAY EXIST IN THE VICINITY OF THE PROJECT WHICH ARE NOT SHOWN ON THE PLANS. IT IS THE RESPONSIBILITY OF THE CONTRACTOR TO LOCATE EXACT ALL EXISTING UTILITIES IN THE VICINITY OF THE PROJECT, PRIOR TO BEGINNING CONSTRUCTION. IF ANY DISCREPANCY EXISTS, NOTIFY ENGINEER.

ONE-CALL NOTIFICATION SYSTEM
CALL BEFORE YOU DIG
48 HOURS NOTICE BEFORE YOU DIG,
DRILL OR BLAST - STOP CALL
TEXAS811 (DIG TESS)(1-800-344-8377)
OR
LONE STAR NOTIFICATION CENTER (1-800-869-8344)

NO.	REVISIONS	DATE
1	AS-BUILT CORRECTIONS	12-5-16

NOTICE:
TO ARRANGE FOR LINES TO BE TURNED OFF OR MOVED, CALL CENTERPOINT ENERGY AT 1-800-272-2222.

PRIVATE UTILITY LINES SHOWN
DATE: 1-27-16

AT&T TEXAS/SWBT FACILITIES
Approved for AT&T/SWBT underground conduit facilities ONLY. SIGNATURE VALID FOR ONE YEAR.


Signature: [Signature] Date: 1/27/16

CENTERPOINT ENERGY/NATURAL GAS FACILITIES VERIFICATION ONLY.
(THIS SIGNATURE VERIFIES THAT YOU HAVE SHOWN CNP NATURAL GAS LINES CORRECTLY.) NOT TO BE USED FOR CONFLICT VERIFICATION. (GAS SERVICE LINES ARE NOT SHOWN.) SIGNATURE VALID FOR SIX MONTHS.

Signature: [Signature] Date: 1/27/16

CENTERPOINT ENERGY/UNDERGROUND ELECTRIC FACILITIES VERIFICATION ONLY.
(THIS SIGNATURE VERIFIES EXISTING UNDERGROUND FACILITIES - NOT TO BE USED FOR CONFLICT VERIFICATION.) SIGNATURE VALID FOR SIX MONTHS.

Signature: [Signature] Date: 1/27/16

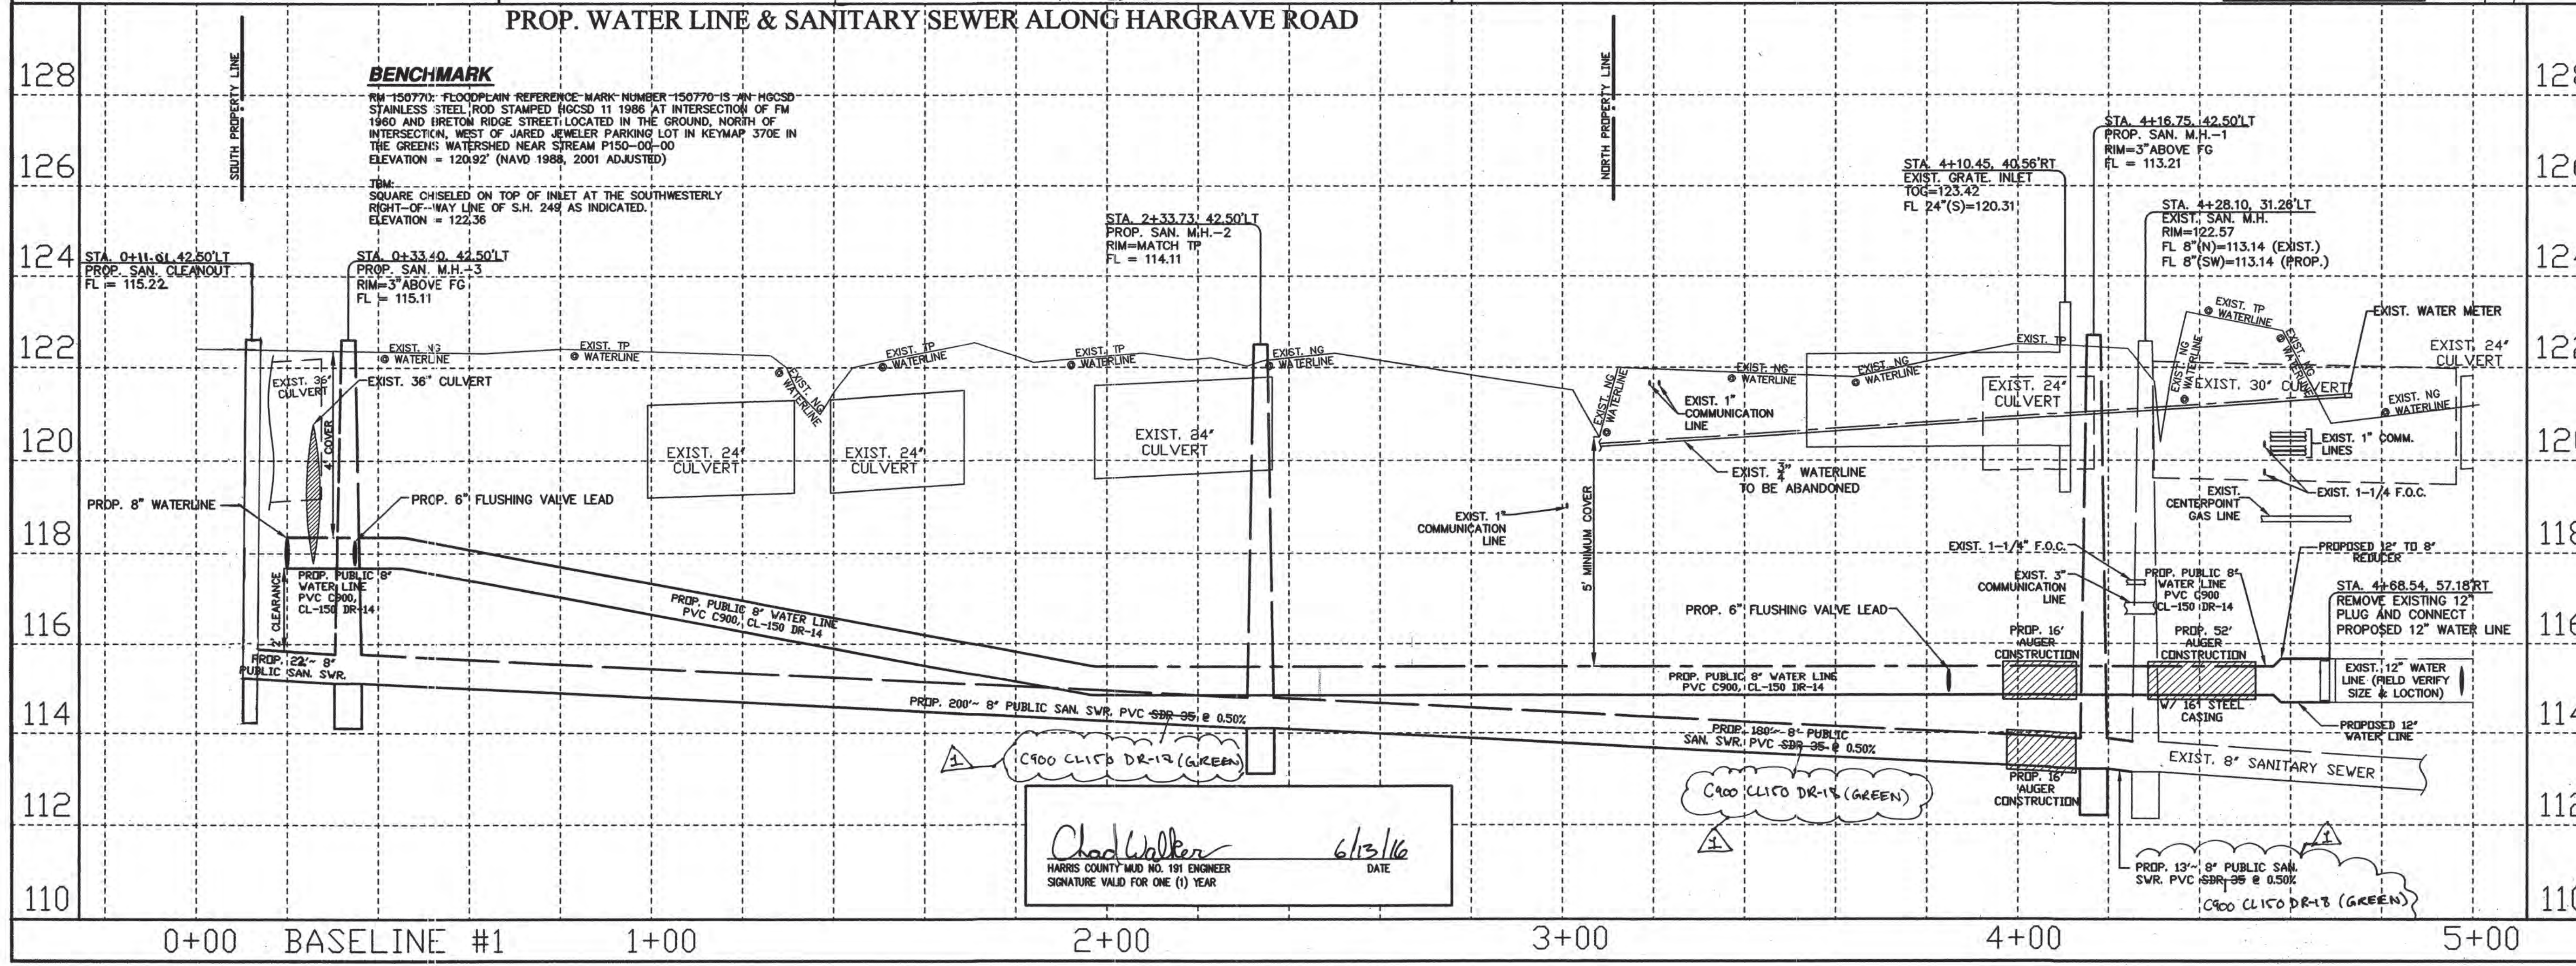

HEIGHTS ENGINEERING LLC
CONSULTING ENGINEERS
7324 SOUTHWEST FWY SUITE 995 HOUSTON, TX 77074
PHONE: (713) 333-0303 FAX: (281) 274-9153
www.HEIGHTSENGINEERING.COM
TEXAS REG. F-12333

PROF. 8" WATER LINE & 8" SANITARY SEWER
ALONG HARGRAVE ROAD
TO SERVICE HARRIS COUNTY MUD #191
HARGRAVE-BASELINE #1 STATION 0+00 TO END
HEIGHTS PROJ. NO: 14-190 DRAWING NO: 14190401
NOTE: CITY SIGNATURES VALID FOR ONE YEAR ONLY AFTER DATE OF SIGNATURES

CITY OF HOUSTON
DEPARTMENT OF PUBLIC WORKS AND ENGINEERING

WATER	TRAFFIC & TRANSPORTATION
WASTEWATER	STORM WATER QUALITY
STORM	FACILITIES
STREET & BRIDGE	

CITY DWG NO: 55439
CITY DRAWING NUMBER

COH LOG# 15-1136
SHEET NO. 6 OF 11

AS-BUILT