


**BENCH MARK**


NATIONAL GEODETIC SURVEY MARKER NO. Y-1216, LOCATED IN CENTER OF HIGHLINE TOWER. (FIRST TOWER N.W. OF F.M. 1960 AND 80' EAST OF R.R. TRACKS) 1979 ADJ. EL. 125.41

**NOTES:**

- CONTRACTOR SHALL VERIFY ALL LOCATIONS & DEPTHS OF ALL UTILITIES, POLES AND PAVEMENTS IN THE FIELD.
- CONTRACTOR TO NOTIFY MR. STEVE SIMMONS AT 869-4571, EXT. 523 OR JESSE GARCIA AT 880-3031 S.D.H.P.T. 48 HOURS PRIOR TO STARTING CONST. IN THE VICINITY OF FM 1960.
- ALL EXISTING WATER LINE FITTINGS, VALVES, AND FLUSH VALVES ARE TO BE SALVAGED AND REUSED IN CONSTRUCTION OF THE NEW WATER LINE. ALL SALVAGED BUT UNUSED FITTINGS AND VALVES SHALL BE DELIVERED TO THE DISTRICTS WATER PLANT FOR STORAGE.
- CONTRACTOR SHALL PERFORM BEDDING AND BACK-FILL OPERATIONS VERY CAREFULLY AND IN ACCORDANCE WITH THE SPECIFICATIONS.
- CONTRACTOR SHALL EXERCISE EXTREME CAUTION WHEN BORING AND JACKING UNDER AND NEAR TREE ROOTS SO AS TO MINIMIZE DISTURBANCE TO THE TREES.
- CONTRACTOR SHALL VERIFY LOCATION OF SPRINKLER LINES AND HEADS ALONG AND NEAR NORTHSIDE OF 10' WATER LINE EASEMENTS.

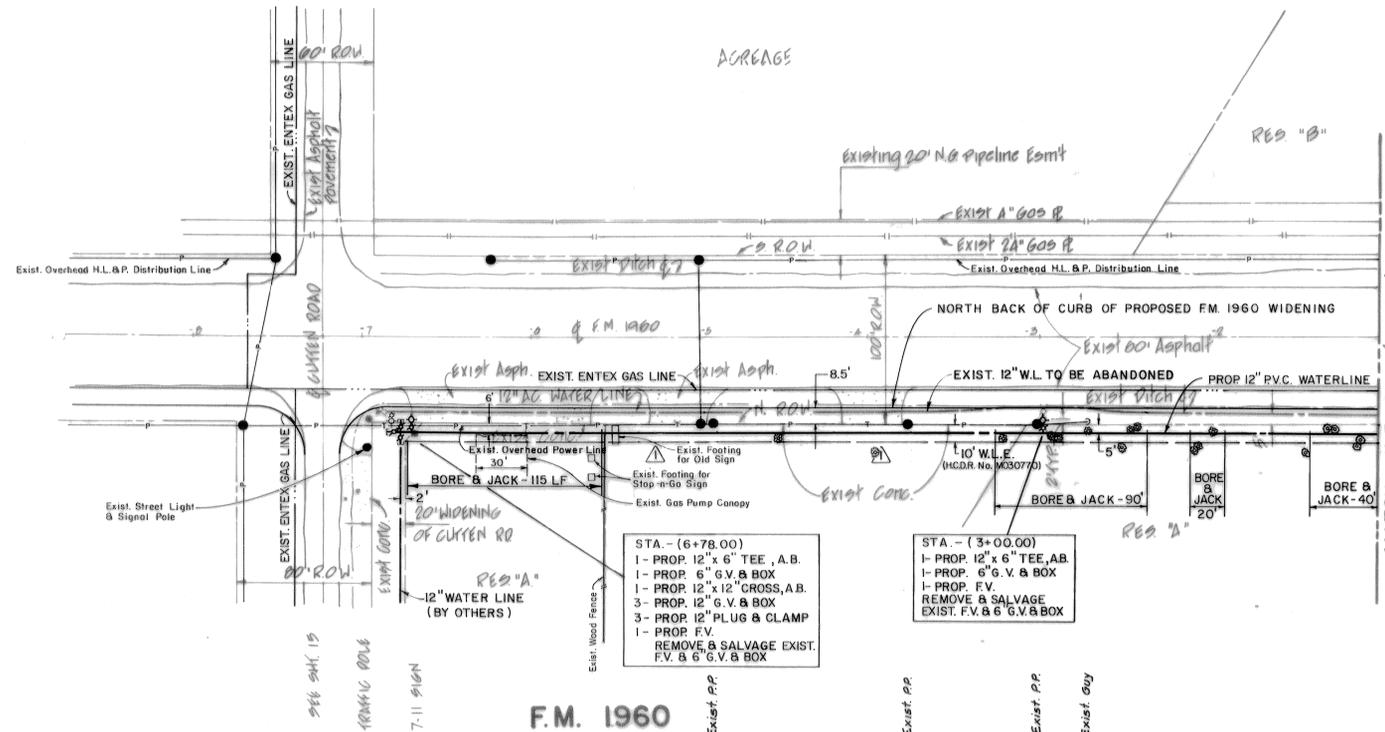

F.M. 1960

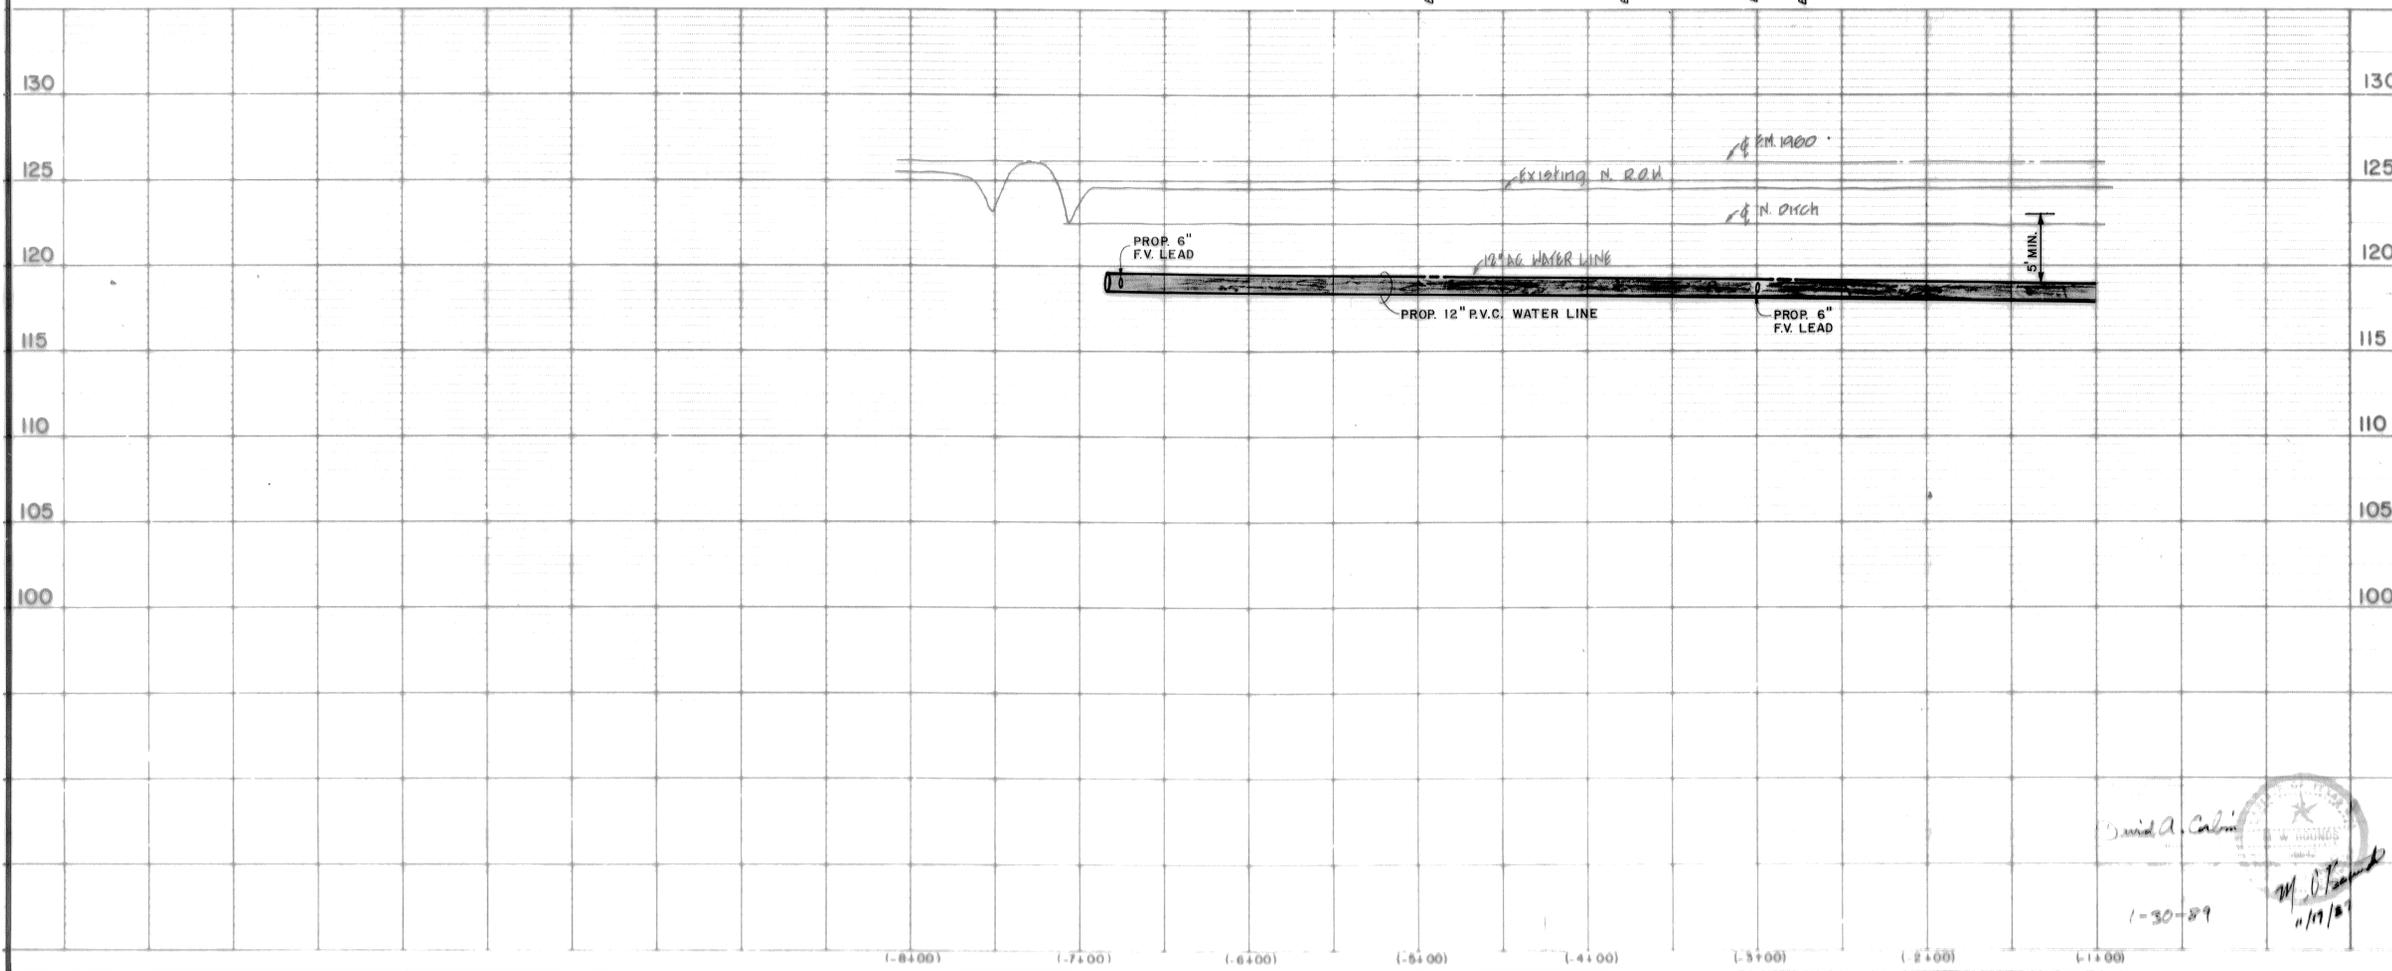

PRIVATE UTILITY LINES SHOWN

*R. Wood* 10-16-87 El. 727 Virginia  
ENTEX, INC.

*M. Nana* 10-22-87  
SOUTHWESTERN BELL TELEPHONE CO.  
Valid for One Year Only

*M. Nana* 11-20-87  
HOUSTON LIGHTING & POWER CO.  
Approval Only for Crossing Underground  
Ductlines Unless Noted. Valid for One Year Only

APPROVED FOR CITY OF HOUSTON

DEPARTMENT OF PUBLIC WORKS:

Water Design: *Water Sales* 12-8-87

Water Quality: *St. G. Long* 12-8-87

Assistant Director - Water Div: *W. G. Long* 12/8/87

Assistant Director: *W. G. Long* 12/8/87

Date: \_\_\_\_\_

OTHER DEPT'S: *12-22-87*

Traffic & Transp. Dept. *12-22-87*

City Planning Dept. *12-22-87*

1-25-89	ADDED BORE & JACK UNDER TREES, RELOCATED VARIOUS FITTINGS		
1-26-88	REMOVE BORE & JACK AT ABANDONED DRIVEWAY ENTRANCES		
Rev.	Date	Description	App.

RELOCATION OF 12" WATER LINE ON F.M. 1960

HARRIS COUNTY M.U.D. No. 191

F.M. 1960

AS-BUILT

STA. -(1+00) TO STA. -(7+00)

Design By: J.W. Job No: 85001-062

Drawn By: J.G.R. Scale: HORIZ. 1"=50'

Checked By: M.W.B. Date: OCTOBER, 1987

Sheet 3 of 5

**LANDEV ENGINEERS, INC.**  
1708 SEAMIST DRIVE  
Houston, Texas 77008

*David A. Calin*

*M. O. ...*

1-30-89

11/1/87