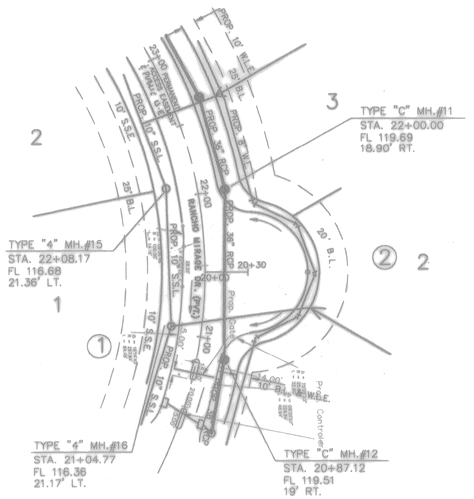

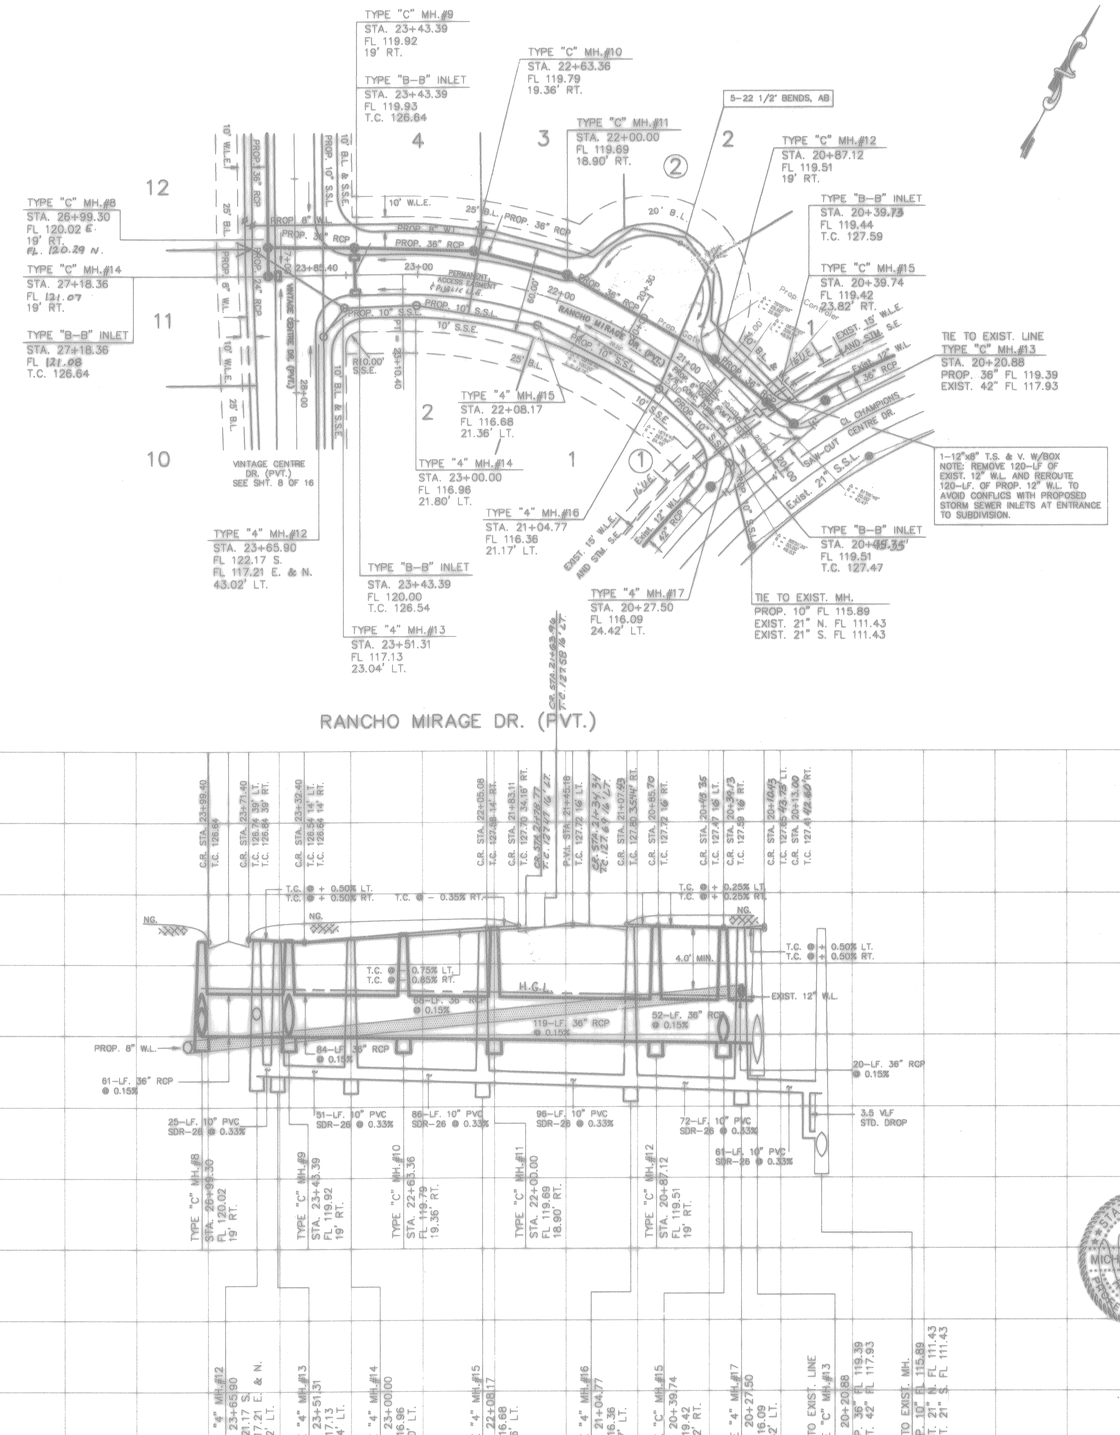

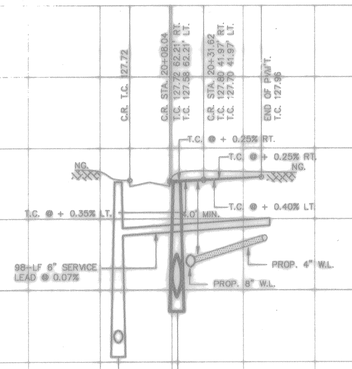

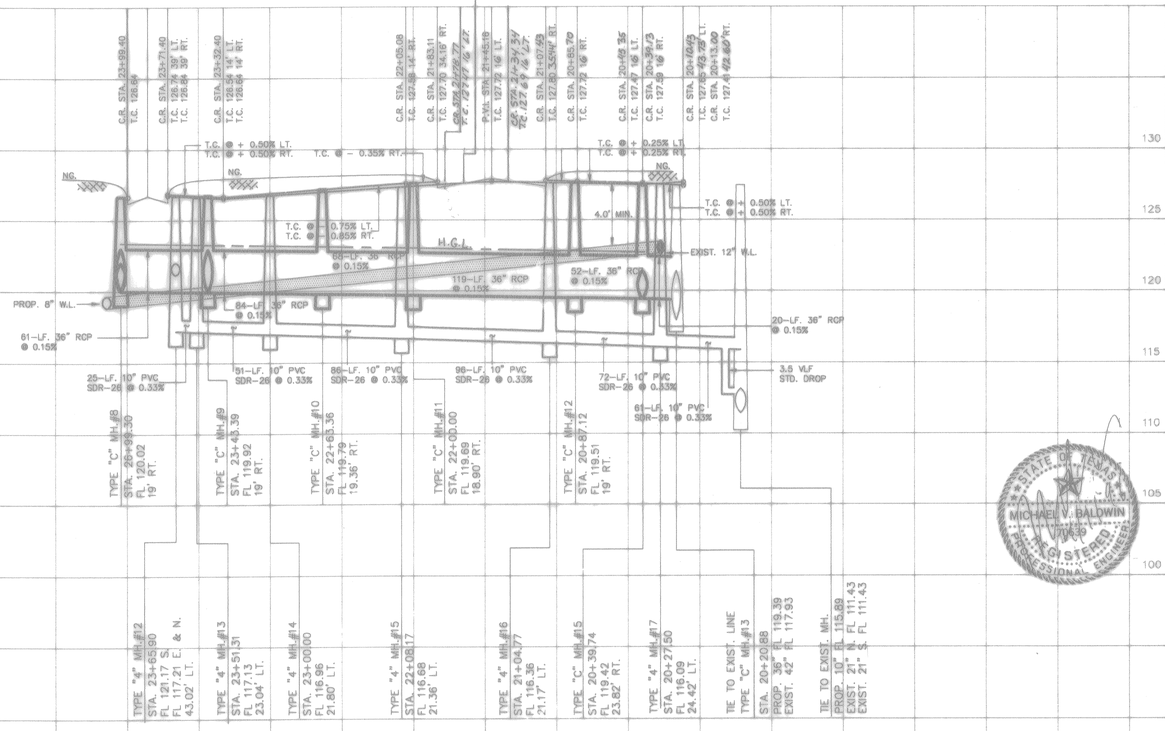

RANCHO MIRAGE DR. (PVT.)

BENCH MARK

BENCH MARK: NGS STAMPED Y1216 1973 BRASS DISK AT CENTERLINE OF H.L.&P. TOWER 1ST TOWER NORTH OF F.M. 1960 ELEVATION 125.99 1973 ADJ.

APPROVED: for County Engineer
6-12-96
Date

Water & Sanitary Sewer Lines Approved as to Location Only

The Above Authorization is Valid for 1 Year Only

Rev.	Date	Description	App.
1	8-6-96	ADD GATED ENTRANCE	

PRIVATE UTILITY LINES SHOWN

Edith A. Wakewall 6/18/96
ENTEX, INC.

6-18-96
SOUTHWESTERN BELL TELEPHONE CO.
Valid for One Year Only

10-18-05
HOUSTON LIGHTING & POWER CO.
Approval Only for Crossing Underground Ductlines Unless Noted. Valid at Time of Review Only.

CITY OF HOUSTON
DEPARTMENT OF PUBLIC WORKS & ENGINEERING
ENGINEERING, CONSTRUCTION AND REAL ESTATE GROUP

SECTION APPROVALS

WATER DESIGN — TRAFFIC AND SIGNAL DESIGN

WASTEWATER DESIGN — STREET, BRIDGE AND RIGHT-OF-WAY DESIGN

STORM SEWER DESIGN — CONSTRUCTION

OTHER DEPARTMENTS

PLANNING AND DEVELOPMENT — SPONSOR DEPARTMENT

CITY ENGINEER — DATE

DIRECTOR OF PUBLIC WORKS AND ENGINEERING — DATE

SUBMITTED:	DESIGNED BY: TIM
SCALE: V: 1" = 5' H: 1" = 50'	DRAWN BY: TIM
DATE: MARCH 1996	SHEET NO. 6 OF 16 SHEETS
SURVEY BY:	
JOB NO: 430-U	CITY DWG. NO. RANCHO.DWG

H.C.M.U.D. NO. 191
PLAN & PROFILE
RANCHO MIRAGE DR.

PROVIDENT ENGINEERS, INC.
12200 N.W. FRWY, Suite 210
Houston, Texas 77092