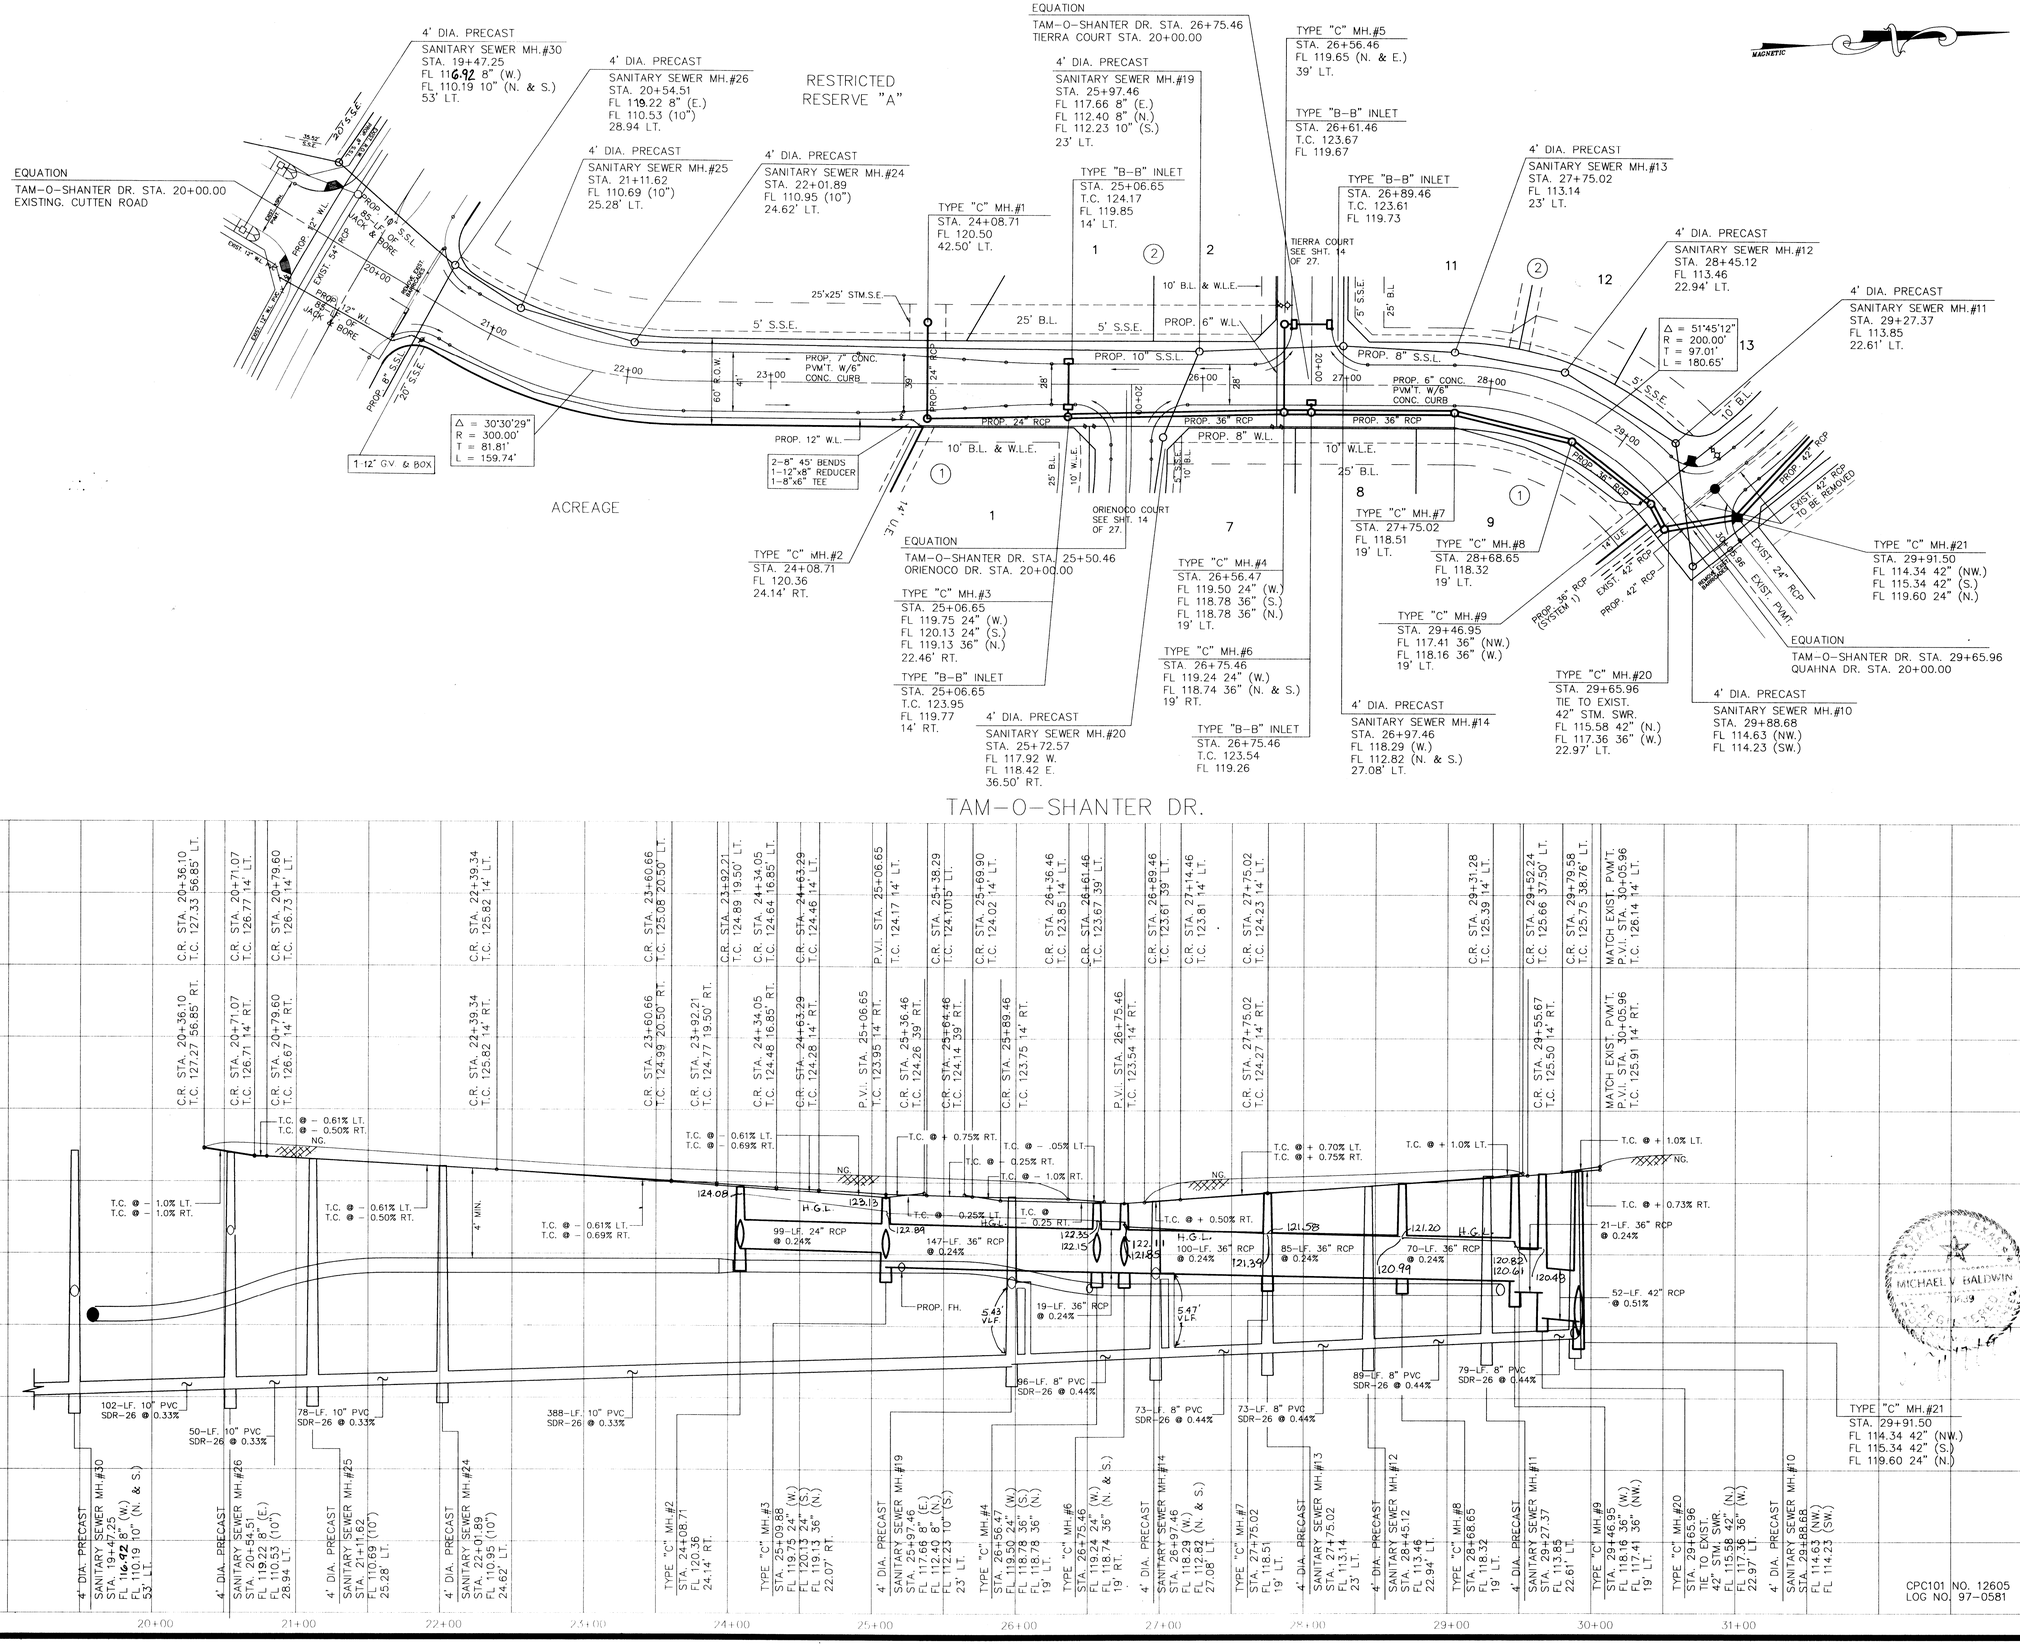

CPC101 NO. 12605
LOG NO. 97-0581

BENCH MARK

BENCH MARK: NATIONAL GEODETIC SURVEY MARKER
Y1216, 1973 ADJ., ELEV = 125.994
Y1216, 1978 ADJ., ELEV = 125.406
Y1216, 1988 ADJ., ELEV = 123.94 ADJUSTMENT USED FOR CUTTEN ROAD.

ELEVATIONS SHOWN HEREON ARE BASED ON 1973 ADJUSTMENT.

TBM#1: TOP OF CURB AT CENTERLINE INLET NORTH SIDE OF TOURNAMNET DRIVE AT CENTERLINE QUEENSCLUB DRIVE ELEV. = 114.69

APPROVED: Assistant County Engineer
2/16/98
Date

Water & Sanitary Sewer Lines Approved as to Location Only
The Above Authorization is Vallid for 1 Year Only

△			
△			
△			
Rev.	Date	Description	App.

PRIVATE UTILITY LINES SHOWN

ENTEX, INC.

SOUTHWESTERN BELL TELEPHONE CO.
Valid for One Year Only

HOUSTON LIGHTING & POWER CO.
Approval Only for Crossing Underground Ductlines Unless Noted. Valid at Time of Review Only.

CITY OF HOUSTON

DEPARTMENT OF PUBLIC WORKS & ENGINEERING
ENGINEERING, CONSTRUCTION AND REAL ESTATE GROUP

SECTION APPROVALS

WATER ENGINEERING 12-9-97	TRAFFIC AND SIGNAL ENGINEERING
WASTEWATER ENGINEERING 1-9-98	STREET & BRIDGE ENGINEERING
STORM SEWER ENGINEERING 12/22/97	CONSTRUCTION

OTHER DEPARTMENTS

PLANNING AND DEVELOPMENT	SPONSOR DEPARTMENT
CITY ENGINEER 1/16/98 DATE	
DIRECTOR OF PUBLIC WORKS AND ENGINEERING 1-16-98 DATE	

MICHAEL V. BALDWIN 79739 LICENSED PROFESSIONAL ENGINEER

SUBMITTED:		DESIGNED BY:	TIM
SCALE:	V: 1" = 5' H: 1" = 50'	DRAWN BY:	TIM
DATE:	AUGUST 1997	SHEET NO.	12 OF 27 SHEETS
SURVEY BY:			
F B NO:		CITY DWG. NO:	

M.U.D. 191
PLAN & PROFILE

TAM-O-SHANTER DR.

PROVIDENT ENGINEERS, INC.
11241 RICHMOND, SUITE E107
HOUSTON, TEXAS 77082