


HARRIS COUNTY MUD 254
 WATER PLANT SITE
 VOLUME 338, PAGE 73
 H.C.M.R.

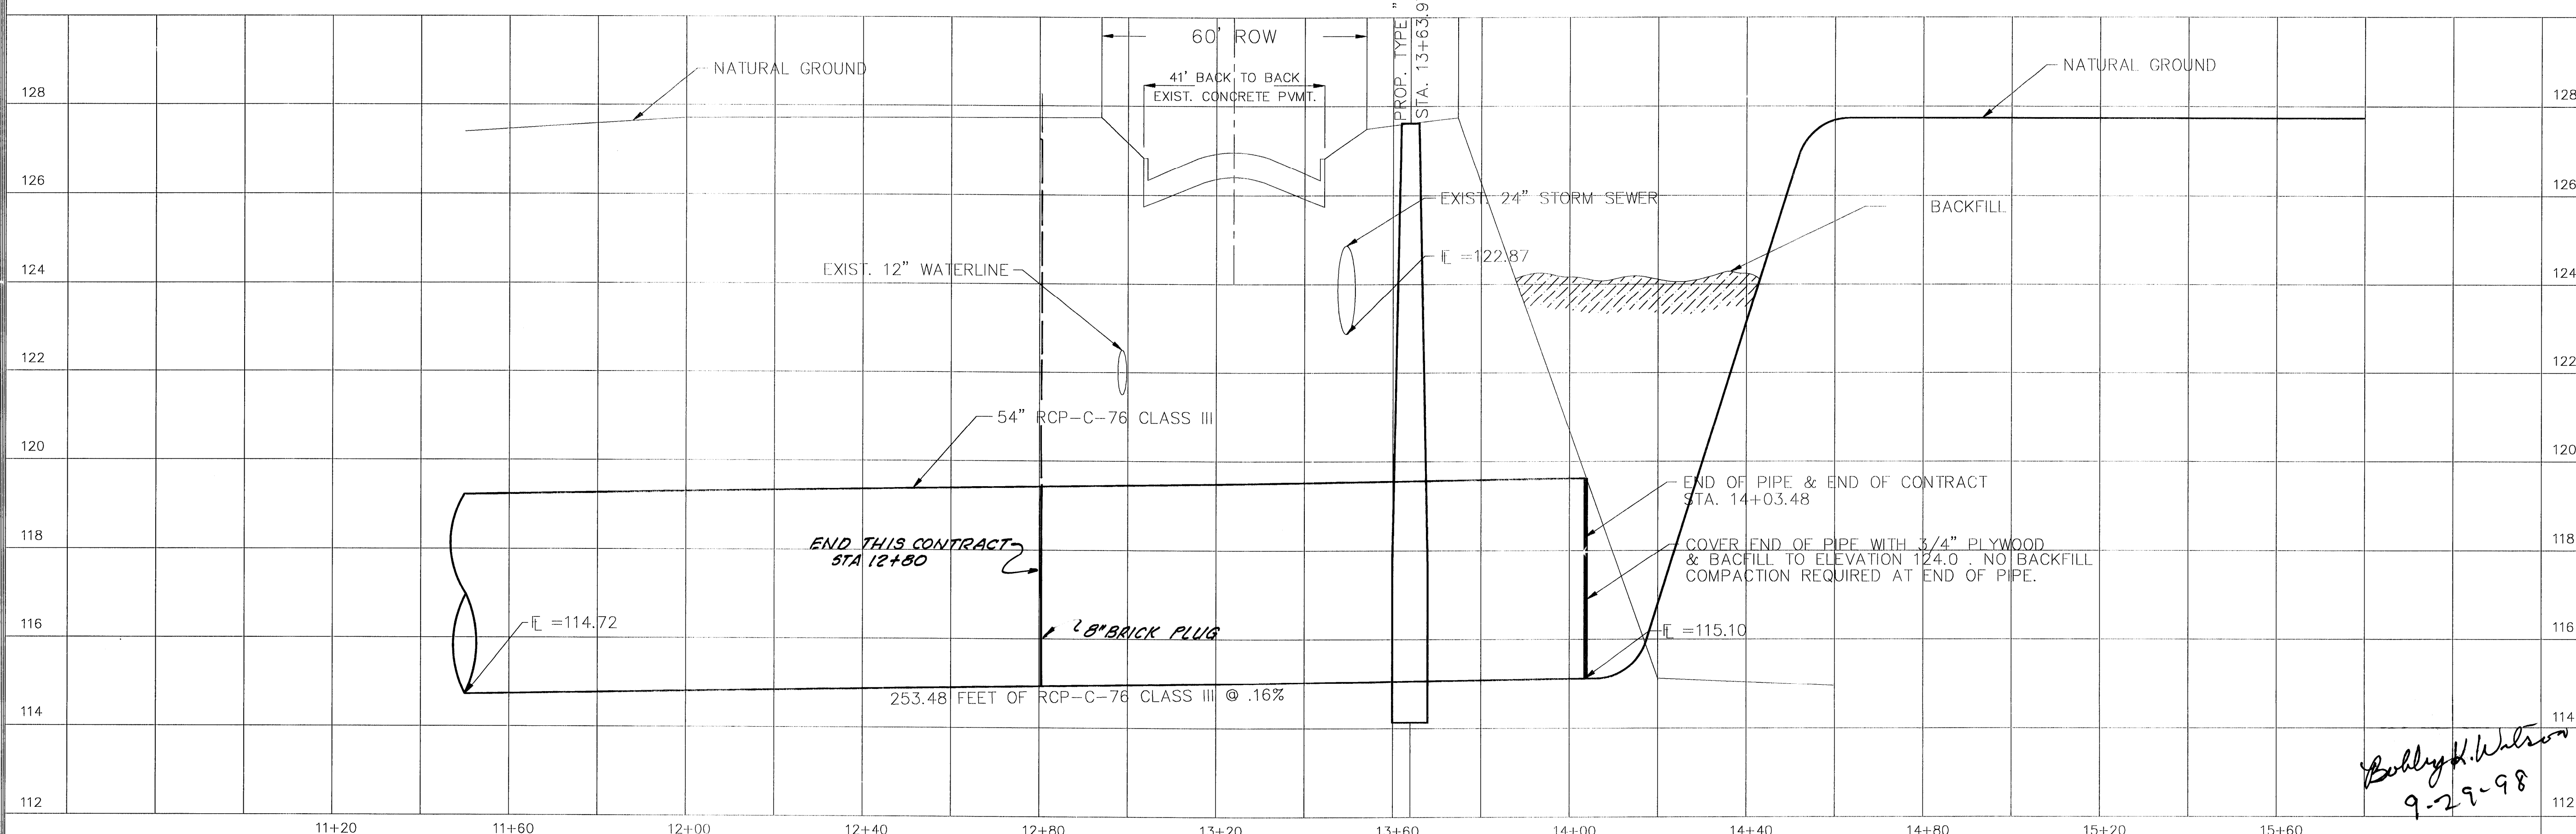

BENCH MARK

APPROVED BY: _____ ASSISTANT FOR COUNTY ENGINEER

DATE _____

WATER & SANITARY SEWER LINES APPROVED AS TO LOCATION ONLY. THE ABOVE AUTHORIZATION IS VALID FOR 1 YEAR ONLY.

Rev.	Date	Description	App.
10-24-98		CHANGED END OF CONTRACT TO STA 12+80	

PRIVATE UTILITY LINES SHOWN

ENTEX, INC. 9/29/98

Nilec Balim 9/28/98

SOUTHWESTERN BELL TELEPHONE CO. Valid for One Year Only

Thomas P. 9.22.98

HOUSTON LIGHTING & POWER CO. Approval Only for Crossing Underground. Ductlines Unless Noted. Valid at Time of Review Only.

CITY OF HOUSTON
 DEPARTMENT OF PUBLIC WORKS & ENGINEERING
 ENGINEERING, CONSTRUCTION AND REAL ESTATE GROUP

SECTION APPROVALS

WATER DESIGN	10/1/98	TRAFFIC AND SIGNAL DESIGN	10/1/98
STORM SEWER DESIGN	10/1/98	STREET, BRIDGE AND RIGHT-OF-WAY DESIGN	10/1/98
WASTEWATER DESIGN		CONSTRUCTION	

OTHER DEPARTMENTS

PLANNING AND DEVELOPMENT

CITY ENGINEER: 10.10.98

DIRECTOR OF PUBLIC WORKS AND ENGINEERING: 10/12/98

SUBMITTED: _____

SCALE: V: 1" = 2', H: 1" = 20'

DATE: 09/26/98

SURVEY BY: _____

JOB NO: 466

DESIGNED BY: BOBBY WILSON

DRAWN BY: BILL DORRIS

SHEET NO. 6 OF 9 SHEETS

DWG. NO. PROF4.DWG

HIGHLAND OAKS
 DETENTION POND OUTFALL
 PLAN & PROFILE
 STA. 11+50 TO STA. 13+843.98

PCI PROVIDENT CONSULTING, INC.
 1200 WEST 11TH ST.
 HOUSTON, TEXAS 77008
 (713)802-1019

Bobby Wilson 9-29-98