
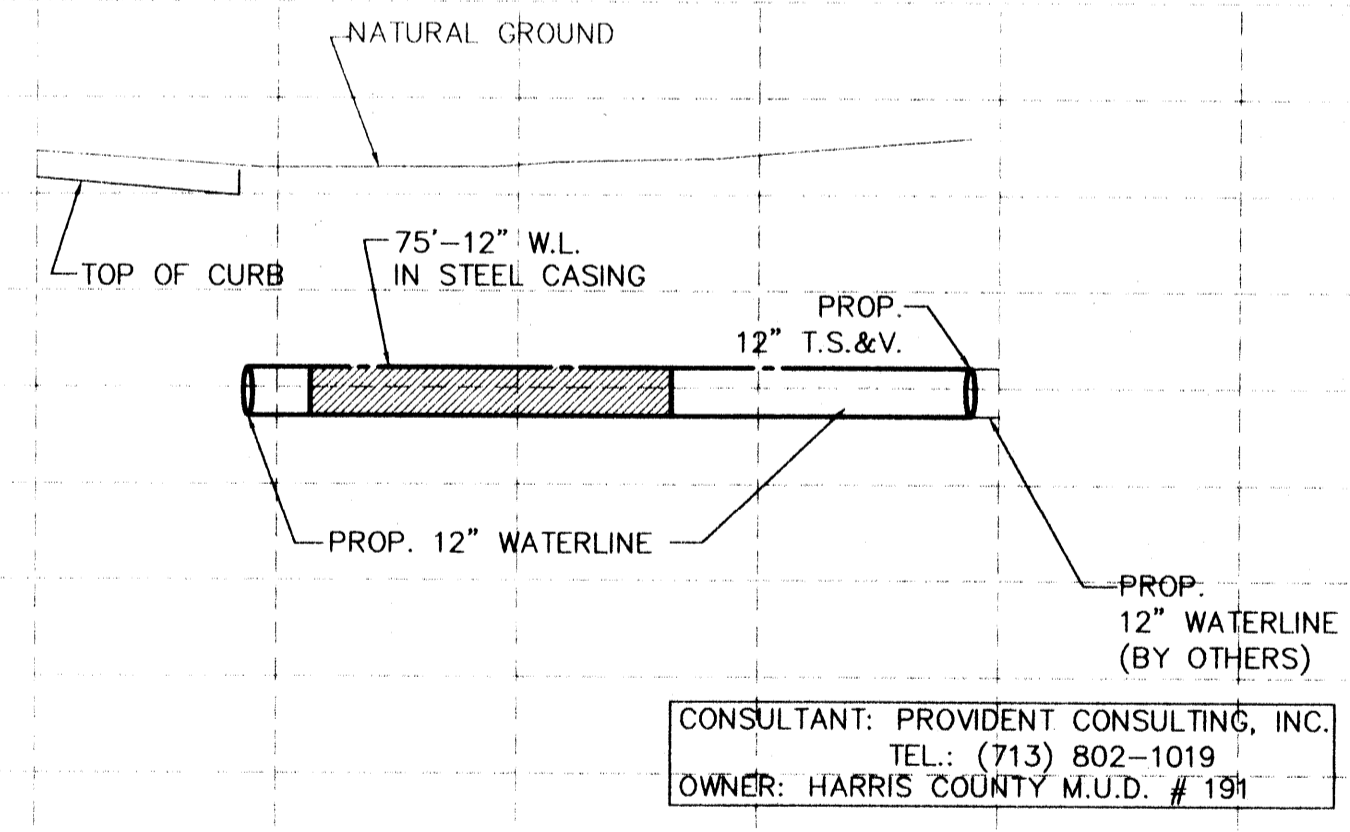


NAPLES PARK LANE

WATERLINE CONNECTION

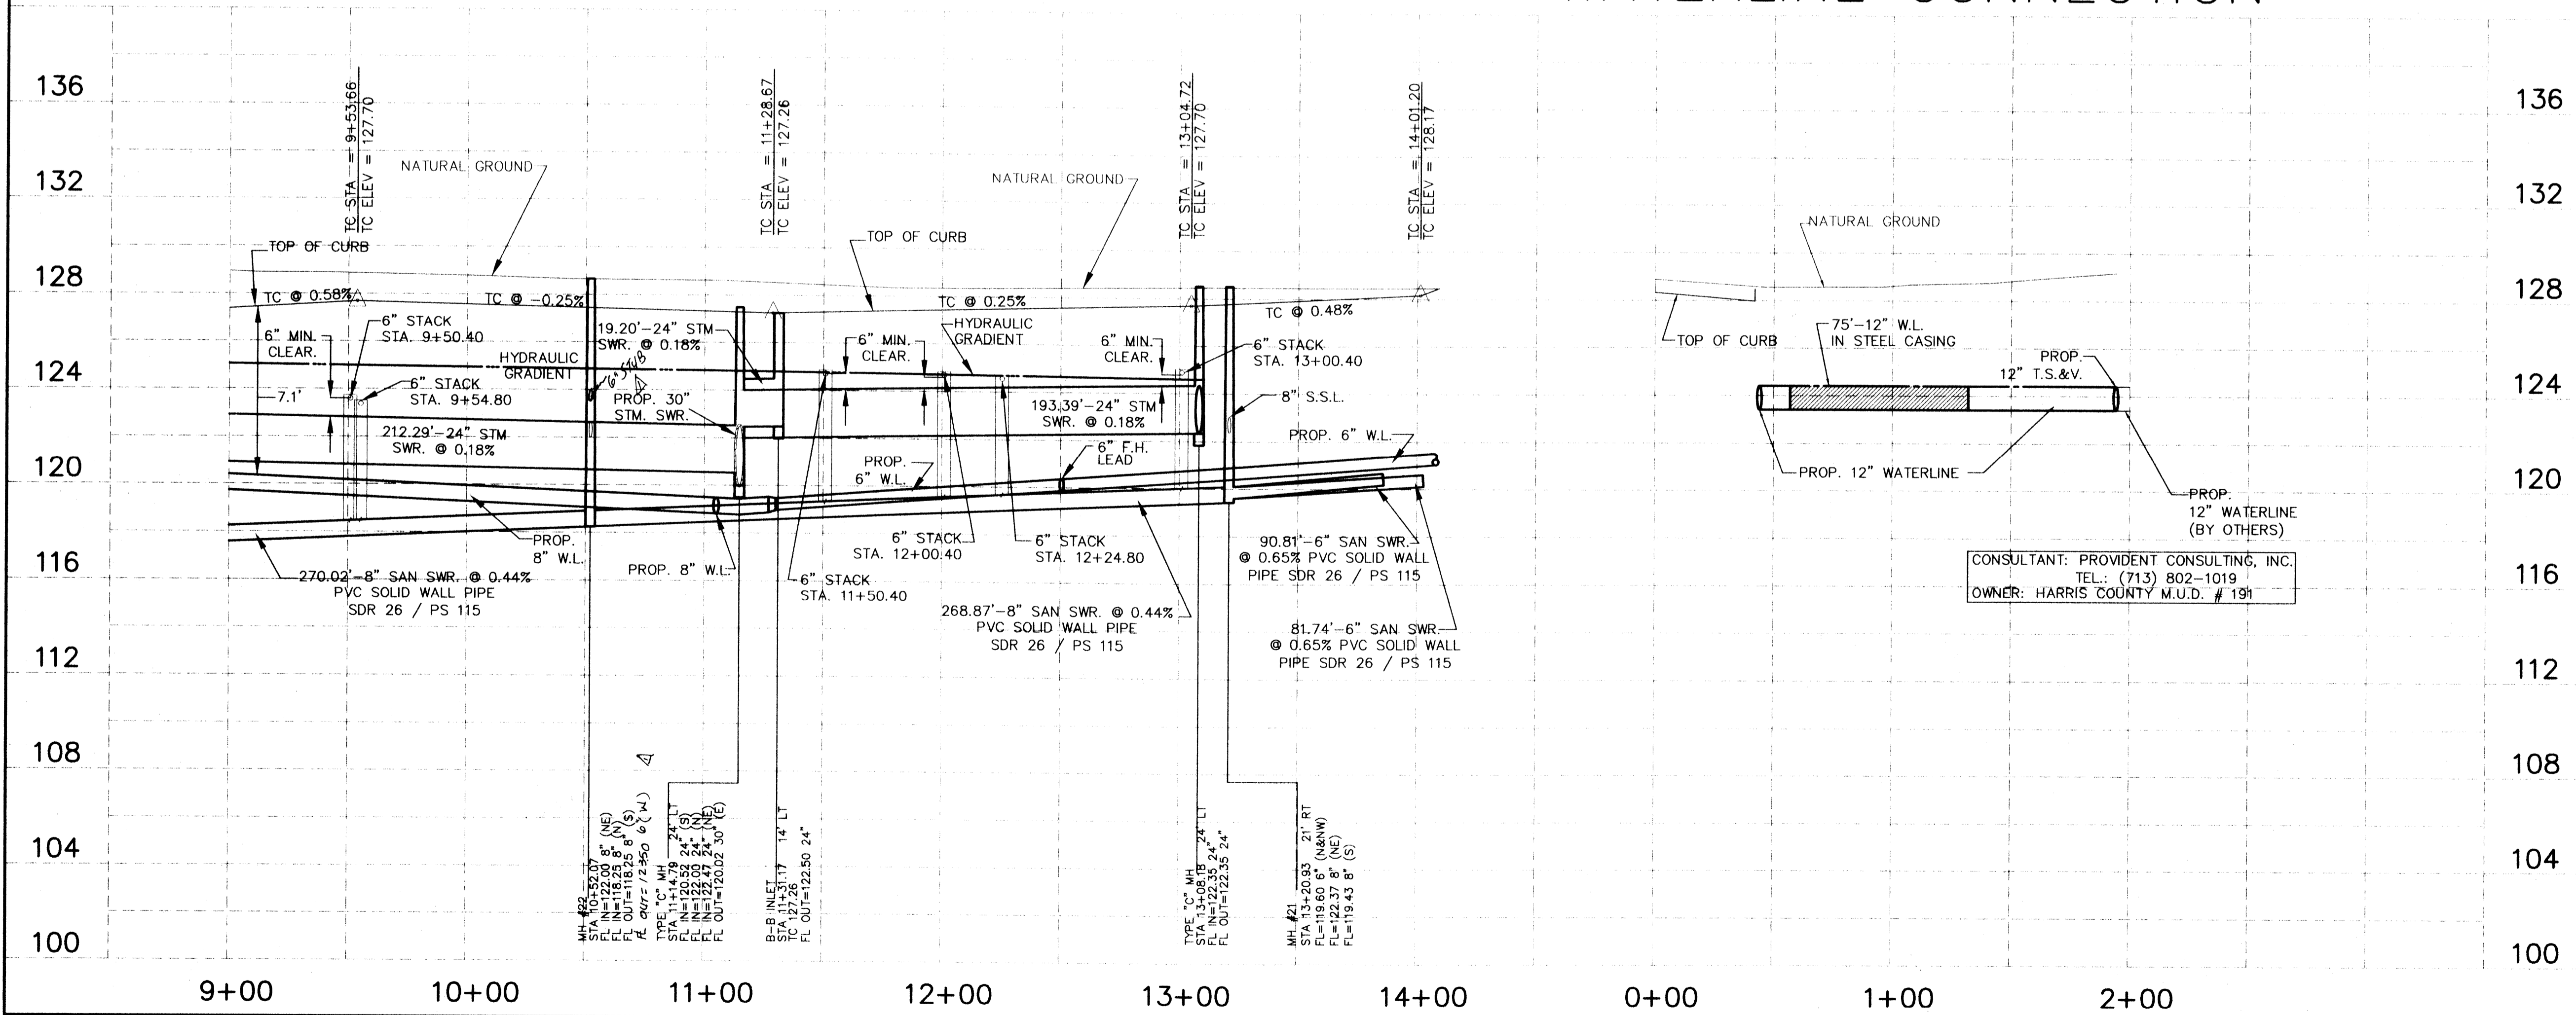

BENCHMARK:
 BM192 Bronze disk set in top of concrete post, approx. 8.7 miles Southeast of Mission, Kansas, Texas Railroad from station at front, approx. 41 feet Northeast of Northeast rail, approx. 2 feet Northeast of fence, and approx. level with rail. 1973 adjustment. Elev. 130.16

NO.	DATE	REVISIONS
1	11/14/00	ADD 6" STUB IN PROFILE

CONSTRUCTION PLANS FOR
 HARRIS COUNTY M.U.D. No. 191
PRESTONWOOD PARK SECTION 1
 HARRIS COUNTY, TEXAS

PROPOSED PAVING, DRAINAGE AND UTILITIES

PRIVATE UTILITY LINES SHOWN

Cal Waterwall 1/4/00 DATE
 ENTEX, INC.
Mike Balin 1/4/00 DATE
 SOUTHWESTERN BELL TELEPHONE CO.
 VALID FOR ONE YEAR ONLY
Cal Waterwall 1/4/00 DATE
 HOUSTON LIGHTING & POWER CO.
 APPROVAL ONLY FOR CROSSING UNDERGROUND
 DUCT LINES UNLESS NOTED. VALID AT TIME OF REVIEW ONLY

HARRIS COUNTY
 PUBLIC INFRASTRUCTURE DEPARTMENT

APPROVED: *[Signature]*
 for Assistant County Engineer
 9 JAN 2000
 Date

Approval implied for paving and drainage facilities within Harris County, R.O.W. and/or jurisdiction. All other improvements in H.C.R.O.W. and/or jurisdiction are approved as to location only.

The above authorization is valid for one (1) year only.

CITY OF HOUSTON
 DEPARTMENT OF PUBLIC WORKS AND ENGINEERING

REVIEWED BY	DATE
<i>[Signature]</i>	1-11-2000
CITY FUNDED PUBLIC WORKS	PROJECT MANAGER
WATER	
WASTEWATER	
STORM WATER	
STREET & BRIDGE	CHIEF ENGINEER

OTHER APPROVAL

TRAFFIC AND TRANSPORTATION SPONSOR DEPARTMENT

CITY ENGINEER *[Signature]* DATE 1-11-2000
 DIRECTOR OF PUBLIC WORKS AND ENGINEERING DATE

SUBMITTED: SCALE: HORIZ. 1" = 40'
 VERT. 1" = 4'
 DATE: DECEMBER, 1999
 SURVEY BY: JOHN THOMAS
 F B NO:

DESIGNED BY: S.A.J.
 DRAWN BY: T.B.M.
 SHEET NO. 13 OF 28 SHEETS
 CITY DWG NO:
 SEAL
[Signature]
 SALIM A. JOHNSON
 38508

PEPE ENGINEERING
 9950 CYPRESSWOOD, SUITE 300
 HOUSTON, TEXAS 77070-4411
 TELEPHONE: (281) 897-0500
 pepenc@pepe-engineering.com

CADD DWG. FILE: 115_853 JOB NO.: 9815
 ORIGINAL SCALE IN INCHES FOR REDUCED PLANS