

BENCHMARK:
 RM192 Bronze disk set in top of concrete post, approx. 8.7 miles Southeast on Missouri-Kansas-Texas Railroad from station at Lumberton, approx. 41 feet Northeast of Northeast rail, approx. 2 feet Northeast of fence, and approx. level with rail. 1973 adjustment. Elev. 130.16'

NO.	DATE	REVISIONS	APP'D.
1	1-22-20	ADD TYPE 'C' M.H.	
2	2-11-20	REVISE FLOW LINE	

CONSTRUCTION PLANS
 FOR
 HARRIS COUNTY M.U.D. No. 191
PRESTONWOOD PARK SECTION 1
 HARRIS COUNTY, TEXAS

PROPOSED
 PAVING, DRAINAGE
 AND UTILITIES
 PRIVATE UTILITY LINES SHOWN

LaWalsh	1/4/00	DAII
ENTEX, INC.		
Nike Bolin	1/4/00	DAII
SOU THEASTERN BELL TELEPHONE CO.		
VALID FOR ONE YEAR ONLY		
LaWalsh	1/4/00	DAII
HOUSTON LIGHTING & POWER CO.		
APPROVAL ONLY FOR CROSSING UNDERGROUND DUCT LINES UNLESS NOTED. VALID AT TIME OF REVIEW ONLY		

HARRIS COUNTY
 PUBLIC INFRASTRUCTURE DEPARTMENT

APPROVED: *[Signature]*
 for Assistant County Engineer
 13 Jan 2000
 Date

Approval implied for paving and drainage facilities within Harris County R.O.W. and/or jurisdiction. All other improvements in H.C.R.O.W. and/or jurisdiction are approved as to location only.

The above authorization is valid for one (1) year only.

CITY OF HOUSTON

DEPARTMENT OF PUBLIC WORKS AND ENGINEERING	REVIEWED BY:	CITY FUNDED PUBLIC WORKS
PRIVATELY FUNDED PUBLIC WORKS	<i>[Signature]</i>	PROJECT MANAGER
WATER	<i>[Signature]</i>	CONSTRUCTION
WASTEWATER	<i>[Signature]</i>	CHIEF ENGINEER
STORM WATER		
STREET & BRIDGE		

OTHER APPROVAL

TRAFFIC AND TRANSPORTATION SPONSOR DEPARTMENT


CITY ENGINEER	DATE
<i>[Signature]</i>	1-11-2000
DIRECTOR OF PUBLIC WORKS AND ENGINEERING	DATE

SUBMITTED:	DESIGNED BY: S.A.J.
SCALE: HORIZ. 1" = 40'	DRAWN BY: T.B.M.
VERT. 1" = 4'	SHEET NO. 16 OF 28 SHEETS
DATE: DECEMBER, 1999	CITY DWG NO.:
SURVEY BY: JOHN THOMAS	
F B NO.:	

SEAL
[Signature]
 SALIM A. J...
 35588
 10/20/99

PEPE ENGINEERING
 9950 CYPRESSWOOD, SUITE 500
 HOUSTON, TEXAS 77070-1412
 TELEPHONE: (281)897-0900
 pepe@pepe-engineering.com

CADD DWG. FILE: 115_856 JOB NO.: 9815
 ORIGINAL SCALE IN INCHES FOR REDUCED PLANS

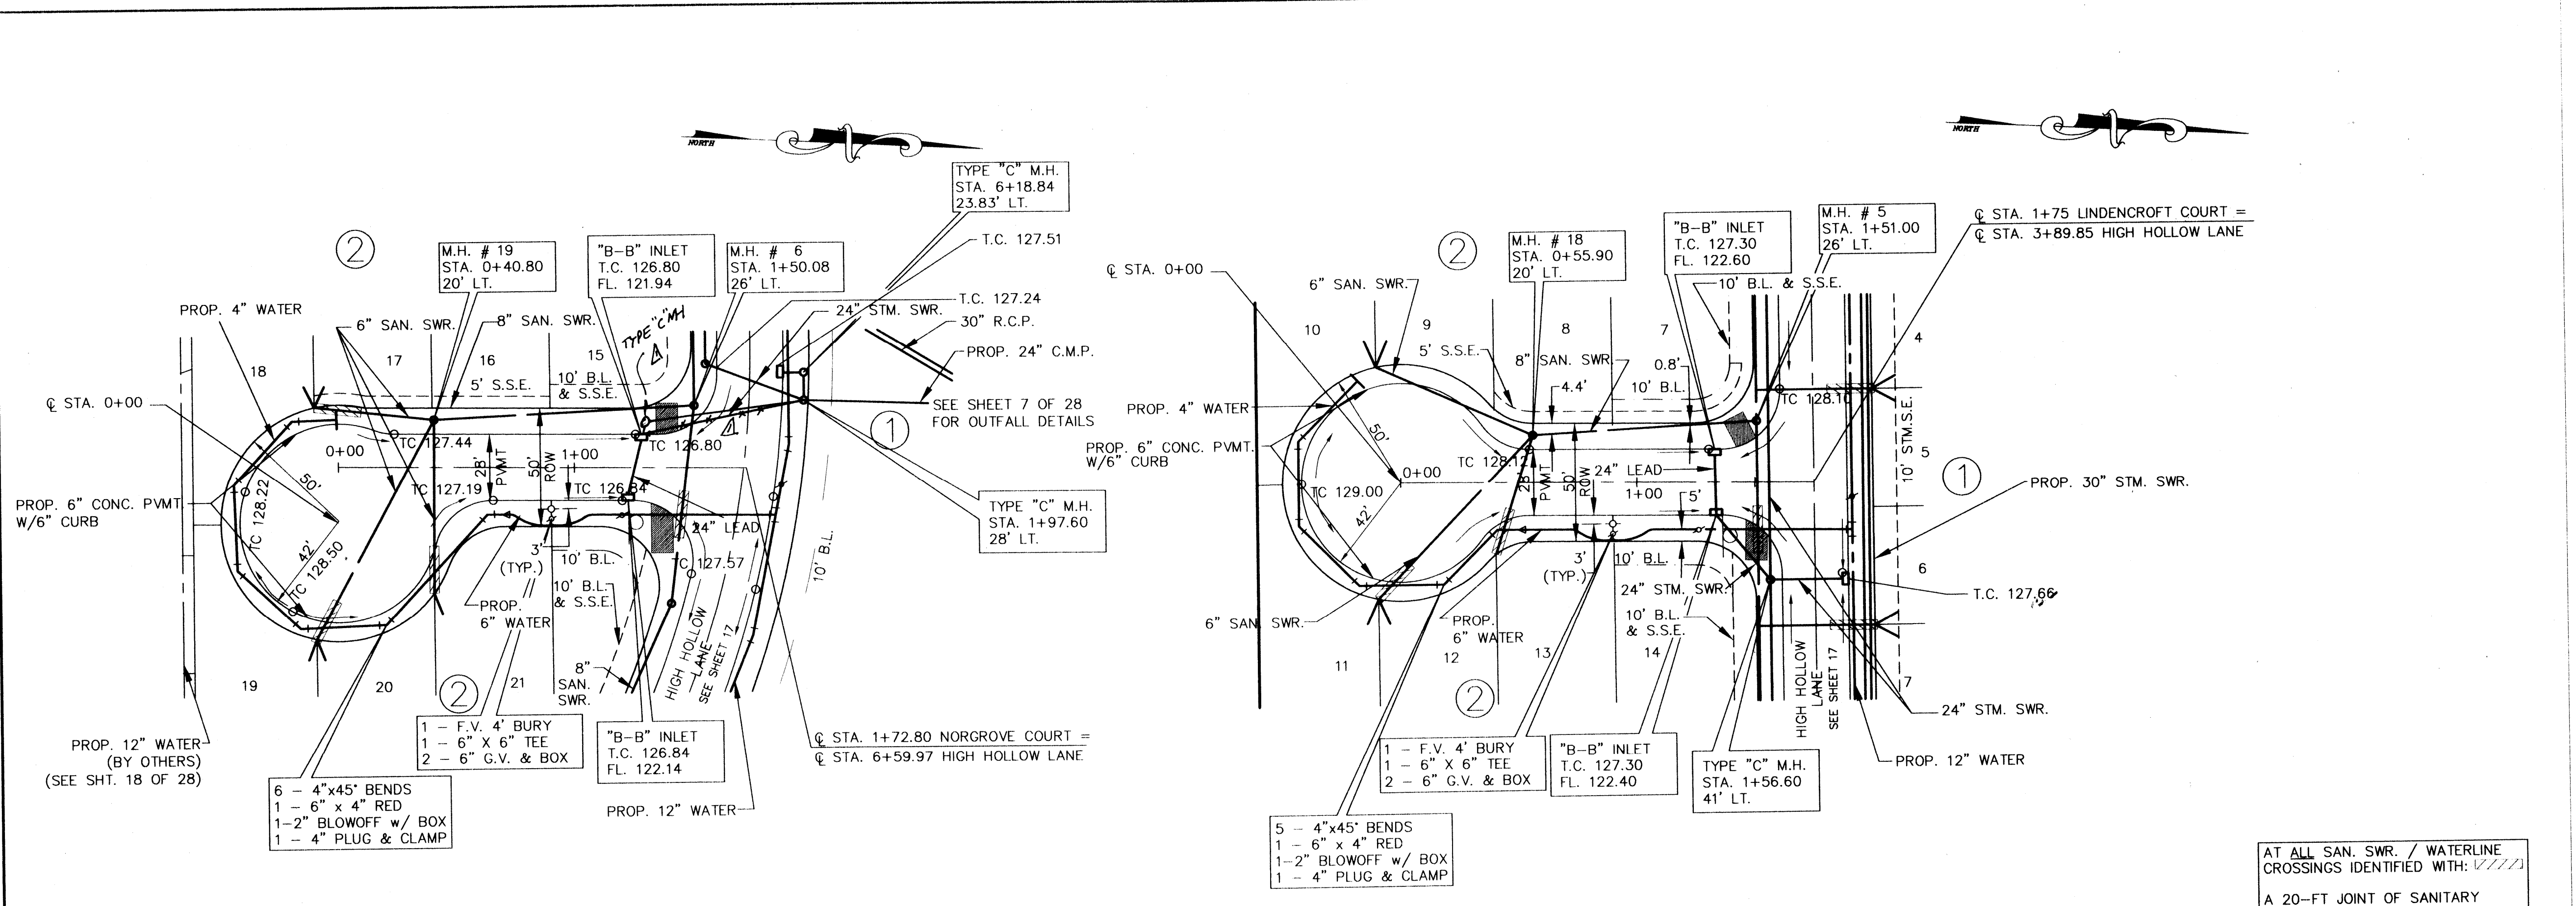

NORGROVE COURT

LINDENCROFT COURT

AT ALL SAN. SWR. / WATERLINE CROSSINGS IDENTIFIED WITH: *[Symbol]*
 A 20'-FT JOINT OF SANITARY SEWER (C-900 PVC PIPE) SHALL BE CENTERED AT WATERLINE.

