


- NOTES:**
- 1- CONTRACTOR SHALL RESTORE ALL DRIVEWAYS TO ORIGINAL OR BETTER CONDITION.
  - 2- CONTRACTOR SHALL RESET EXISTING CULVERTS AND RE-GRADE EAST DITCH TO EXISTING CONDITIONS.
  - 3- CONTRACTOR SHALL EXERCISE EXTREME CAUTION WHEN BORING UNDER SCHROEDER ROAD WITH RESPECT TO EXISTING UTILITIES. CONTRACTOR IS RESPONSIBLE FOR VERIFYING LOCATION OF ALL EXISTING UTILITIES AND SHALL NOTIFY THE ENGINEER OF ANY CONFLICTS BETWEEN EXISTING AND PROPOSED UTILITIES.
  - 4- CONTRACTOR SHALL PROVIDE FOR THE ENGINEER'S REVIEW, A BORING AND TUNNELING PLAN PRIOR TO CONSTRUCTION.
  - 5- CONTRACTOR IS RESPONSIBLE FOR PROVIDING A TRAFFIC CONTROL PLAN AND FOR MAINTAINING PUBLIC SAFETY AT ALL TIMES.
  - 6- CONTRACTOR SHALL PROTECT ROADWAY FROM BEING UNDERMINED BY TRENCH EXCAVATION.
  - 7- CONTRACTOR SHALL BE RESPONSIBLE FOR REPLACING ANY FENCES OR EXISTING UTILITIES AND APPURTENANCES DAMAGED DURING CONSTRUCTION.
  - 8- CONTRACTOR SHALL BE RESPONSIBLE FOR OBTAINING ALL PERMITS REQUIRED BY HARRIS COUNTY - PERMIT DIVISION.
  - 9- WHERE ASPHALT PAVEMENT IS DISTURBED, PAVEMENT IS TO BE OVERLAID.

# SCHROEDER ROAD

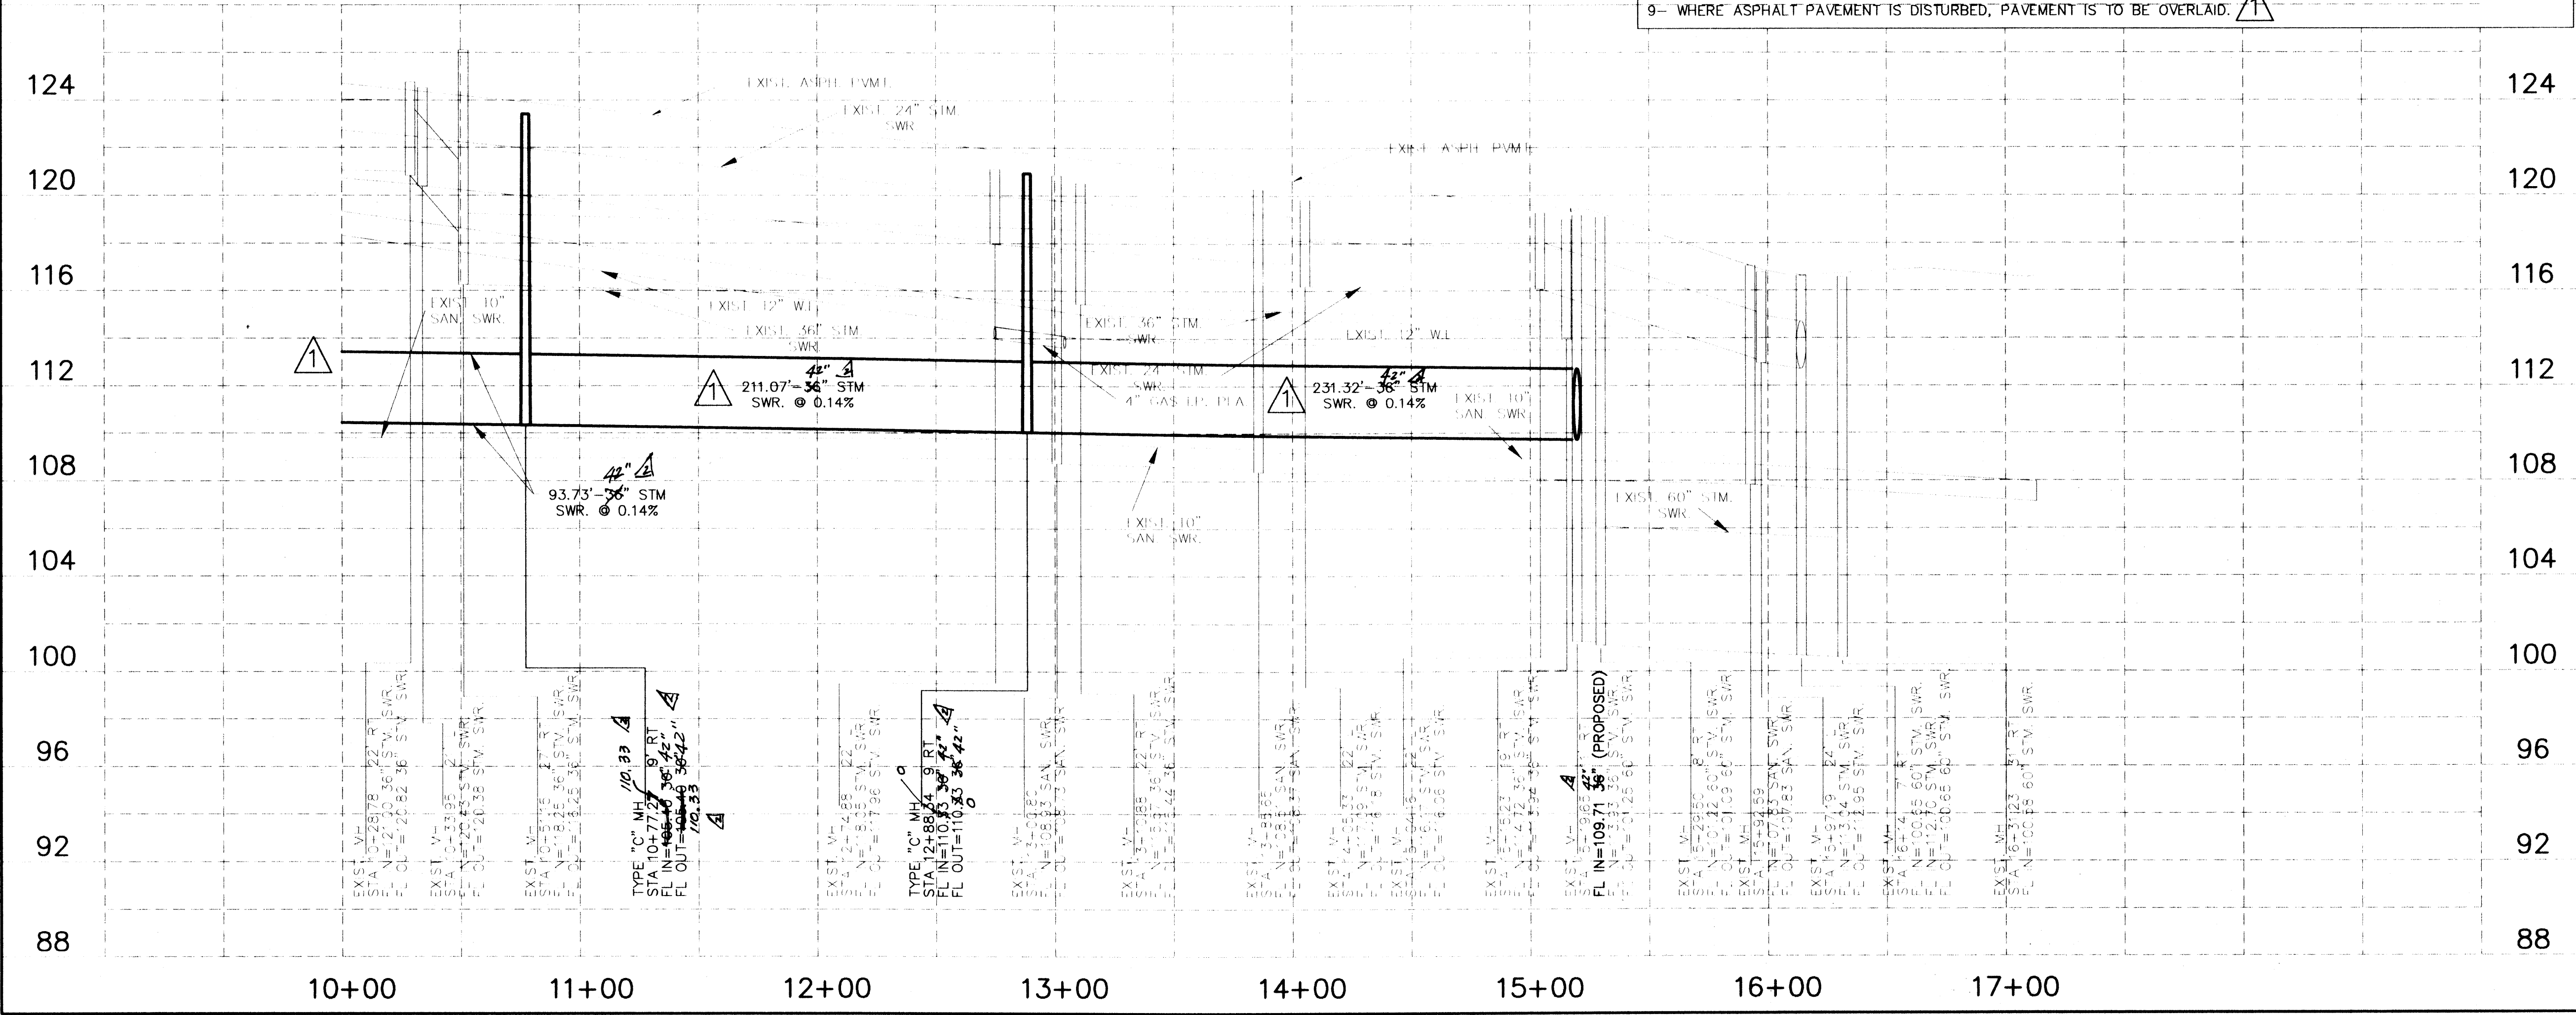

**BENCHMARK:**  
 BM192 Bronze disk set in top of concrete post, approx. 8.7 miles Southeast on Missouri-Kansas-Texas Railroad from station at Ironhill approx. 41 feet Northeast of Northeast rail, approx. 2 feet Northeast of fence, and approx level with rail. 1973 adjustment. Elev. 130.16

NO.	DATE	REVISIONS	BY
A	5/8/00	5/8/00 CHANGED STORM SEWER TO 42"	JTB
A	5/8/00	REVISED STORM SEWER ADDED NO. 1	JTB

CONSTRUCTION PLANS  
 FOR  
 HARRIS COUNTY M.U.D. No. 191  
**PRESTON PARK SECTION 1**  
 HARRIS COUNTY, TEXAS

PROPOSED  
 PAVING, DRAINAGE  
 AND UTILITIES

PRIVATE UTILITY LINES SHOWN

ENTEX, INC.	DATE:
SOUTHWESTERN BELL TELEPHONE CO.	DATE:
HOUSTON LIGHTING & POWER CO.	DATE:

APPROVAL ONLY FOR CROSSING UNDERGROUND DUCT LINES UNLESS NOTED. VALID AT TIME OF REVIEW ONLY

**HARRIS COUNTY**  
 PUBLIC INFRASTRUCTURE DEPARTMENT

APPROVED: *[Signature]*  
 for Assistant County Engineer  
 Date: 11 May 2000

Approval implied for paving and drainage facilities within Harris County R.O.W. and/or jurisdiction. All other improvements in H.E.C.R.O.W. and/or jurisdiction are approved as to location only.


The above authorization is valid for one (1) year only.  
**CITY OF HOUSTON**  
 DEPARTMENT OF PUBLIC WORKS AND ENGINEERING

REVIEWED BY	
PRIVATELY FUNDED PUBLIC WORKS	CITY FUNDED PUBLIC WORKS
WATER	PROJECT MANAGER
WASTEWATER	CONSTRUCTION
STORM WATER	CHIEF ENGINEER
STREET & BRIDGE	

OTHER APPROVAL

TRAFFIC AND TRANSPORTATION	SPONSOR DEPARTMENT
CITY ENGINEER	DATE:
DIRECTOR OF PUBLIC WORKS AND ENGINEERING	DATE:

SUBMITTED:	DESIGNED BY: T.A.
SCALE: HORIZ. 1" = 40'	DRAWN BY: T.E.M.
DATE: DECEMBER, 1999	SHEET NO. 21A OF 23 SHEETS
SURVEY BY: JOHN THOMAS	CITY DWG NO:
F.B. NO:	

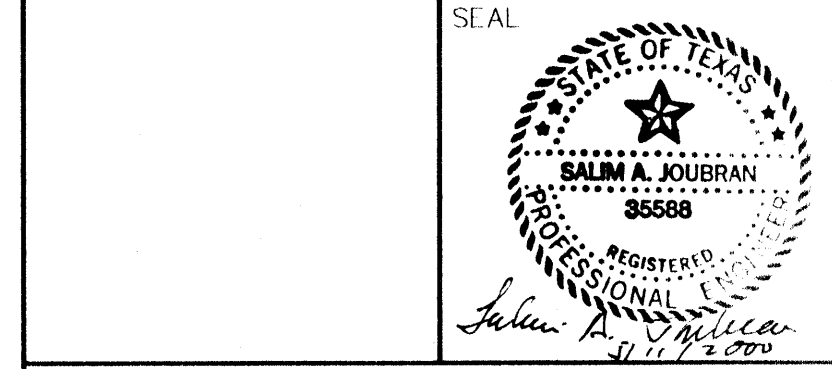

**PEPE ENGINEERS**  
 9950 CYRUSWORKS, SUITE 100  
 HOUSTON, TEXAS 77055  
 TELEPHONE: 281-887-7000  
 FAX: 281-887-7001  
 www.pepe-engineers.com

CADD DWG. FILE: 135-862	JOB NO.: 1999
ORIGINAL SCALE IN INCHES FOR REDUCED PLANS:	