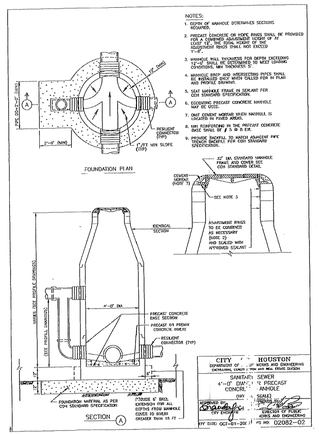

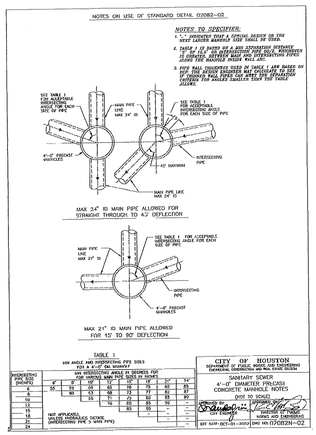

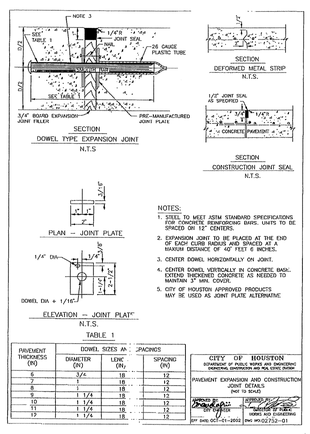

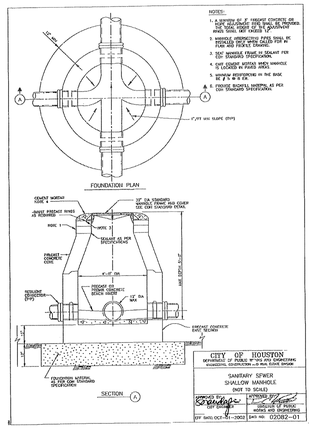

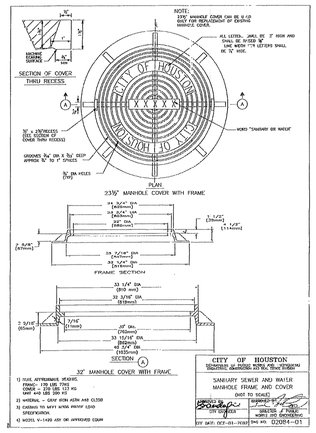

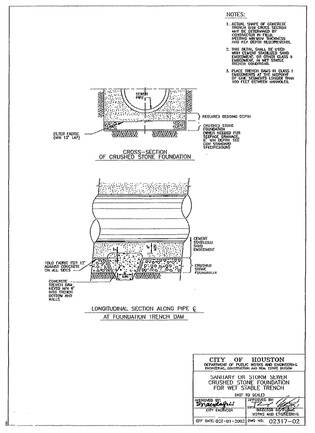

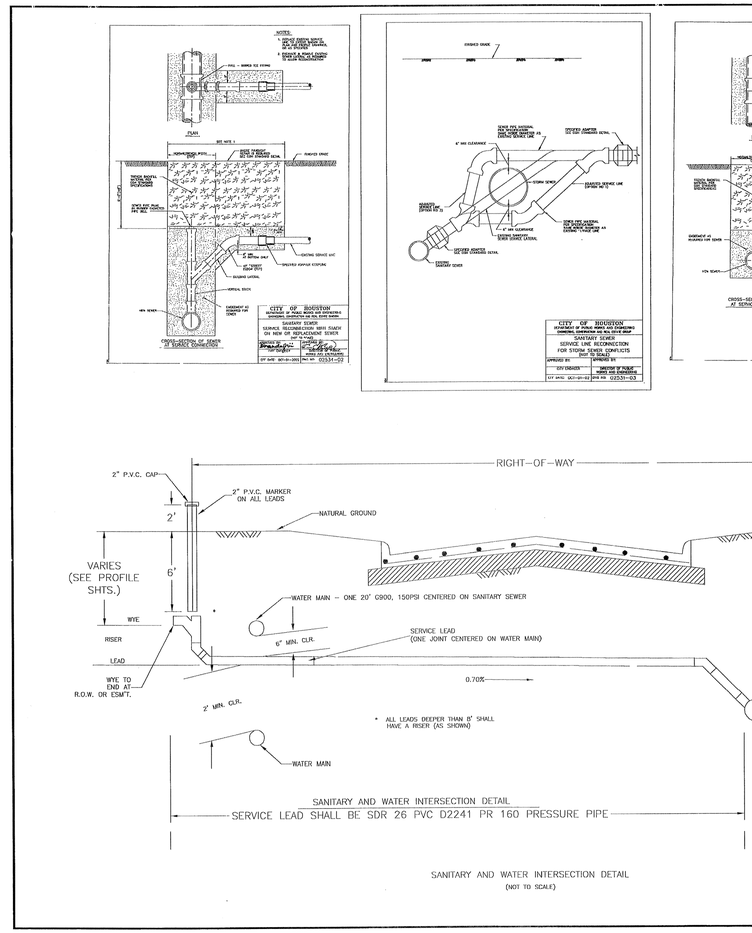

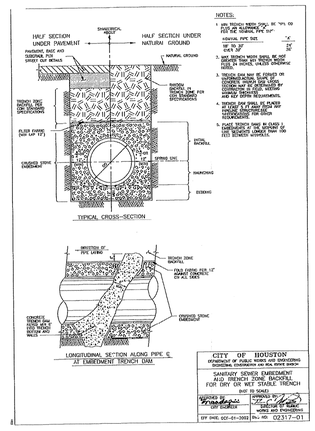

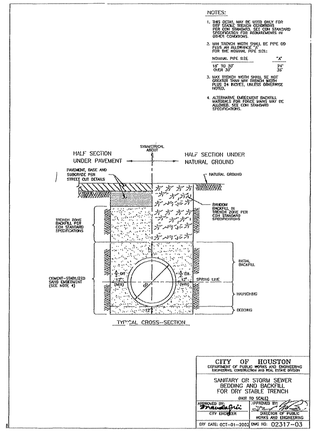

VILLAS AT WILLOWBROOK

SANITARY SEWER DETAILS

WATER	WASTEWATER	TRAFFIC
9/1/5	9-7-05	
ST. & BRIDGE	STORM WATER	SWQ
	9/7/05	

FILE NO:

DRAWING SCALE:

SCALE NONE

SHEET No: 17 OF 24

PCI
PROVIDENT CONSULTING, INC.
1405 ALLSTON ST.
HOUSTON, TEXAS 77008
(713)802-1019

DRAWN BY: BILL DORRIS DWG. NAME: ACAD-17 DETAIL SANITARY.DWG