

STABLECHASE APARTMENTS
 FILM CODE NO. 418086
 M.R.H.C.

PRESTONWOOD FOREST
 SECTION ONE
 VOLUME 173, PAGE 126
 M.R.H.C.

COOLSHIRE LANE
 (60' R.O.W.)

SCHROEDER ROAD (90' R.O.W.)



STRATFORD WAY (50' R.O.W.)

CHAMPIONS ARBOR
 FILM CODE NO. 448016
 M.R.H.C.

VILLAS AT WILLOWBROOK
 FILM CODE NO. 601037
 M.R.H.C.


4.98940 ACRES
 H.C.C.F. NO. S65B968

MCCONNELL PLACE

- LEGEND:
- BO = BLOW-OFF VALVE
 - FH = FIRE HYDRANT
 - GI = GRATE INLET
 - MH = MANHOLE
 - PVT SAN = PRIVATE SANITARY SEWER LINE
 - PVT STM = PRIVATE STORM SEWER LINE
 - PVT WATER = PRIVATE WATER LINE
 - SANMH = SANITARY MANHOLE
 - STMH = STORM MANHOLE
 - WM = WATER METER
 - WV = WATER VALVE



- NOTES:
1. THE UNDERGROUND UTILITIES ARE SHOWN IN THEIR APPROXIMATE LOCATION BASED ON ABOVE GROUND EVIDENCE. SURVEYOR DID NOT EXCAVATE OR PROBE UNDERGROUND UTILITY LINES
 2. LOCATION OF WATER VALVE OR WATER METER AS STAKED PRIOR TO CONSTRUCTION, UNABLE TO LOCATE DUE TO CONSTRUCTION DEBRIS.

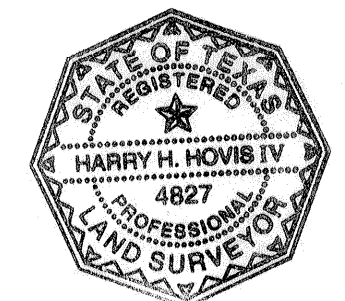

Harry H. Hovis IV
 Registered Professional Land Surveyor

H S C HOVIS SURVEYING COMPANY Land Surveys - Computer Mapping
 5000 Cabbage - Spring, Texas 77379
 (281) 320-8501
 Accege - Residential - Industrial - Commercial

EXHIBIT SHOWING UTILITIES AT VILLAS OF WILLOWBROOK, SITUATED IN THE LORENZO DE ZAVALLA SURVEY, ABSTRACT NUMBER 950, HARRIS COUNTY, TEXAS.