EQUATION:
STA. 0+00.00 F.M. 1960
STA. 5+30.00 CHAMPIONS CENTRE DR.

EQUATION:
STA. 3+16.73 F.M. 1960 N. ROW =
STA. 0+00.0 WILLOW CENTRE DR 50' L.T.

NOTE:
1. CONTRACTOR TO ADJUST & OR REPLACE EXIST. LIGHT STD'S., SIGNS, IN POLES, JUNCTION BOXES, ASPH. PVMT. AND FENCES TO CONFORM TO EX. B. CONDITIONS.
2. CONTRACTOR TO GRADE EXIST. DITCH 100' LF TO MATCH & FROM ENDS OF CROSSPIPE OF EXIST. DITCH
3. CONTRACTOR TO NOTIFY MR. W.N. TAYLOR T.D.H.P.T. 713-440-2822 PRIOR TO STARTING CONST. IN THE VICINITY OF F.M. 1960
4. CONTRACTOR TO ADJUST OR REPLACE EXIST. 10'W x 7'D CONC. BOX CULVERT OUTFALL AS NECESSARY TO ACCOMMODATE DITCH ENLARGEMENT.

BENCH MARK
NATIONAL GEODETIC SURVEY MARKER NO. Y-1216, LOCATED IN CENTER OF HIGHLINE TOWER. (FIRST TOWER N.W. OF F.M. 1960 AND 80' EAST OF R.R. TRACKS)
1979 ADJ EL. 125.41

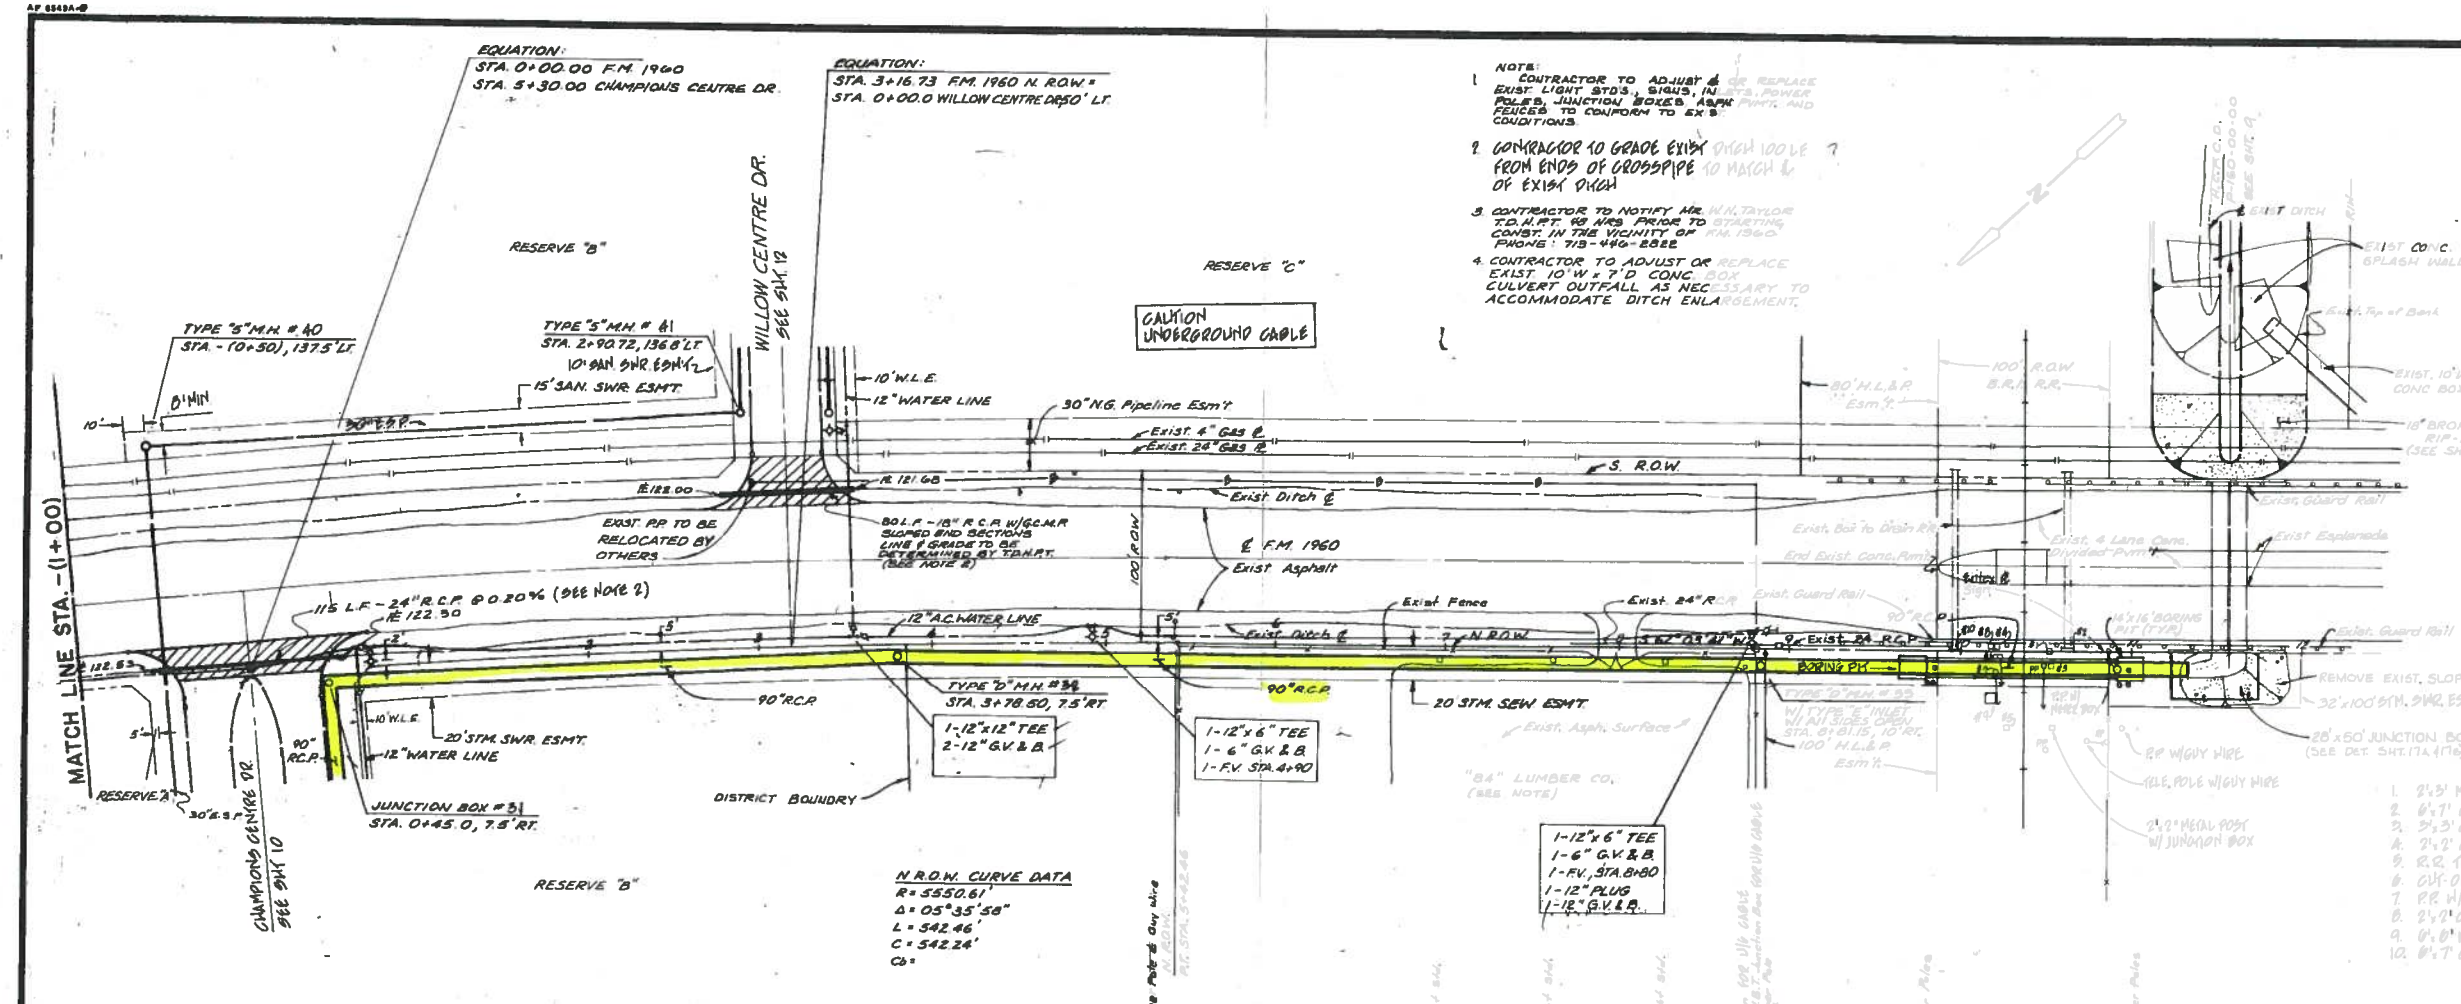

APPROVED: Richard N. Stone
County Engineer
APPROVED: 12-16-82
Engineer in Charge
Water & Sanitary Sewer Lines Approved as to location only.

APPROVED
R. L. Millard
2/13/84
THE ABOVE SIGNATURE VALID FOR ONE (1) YEAR ONLY
APPROVED
R. L. Millard
5/8/82
THE ABOVE SIGNATURE VALID FOR ONE (1) YEAR ONLY

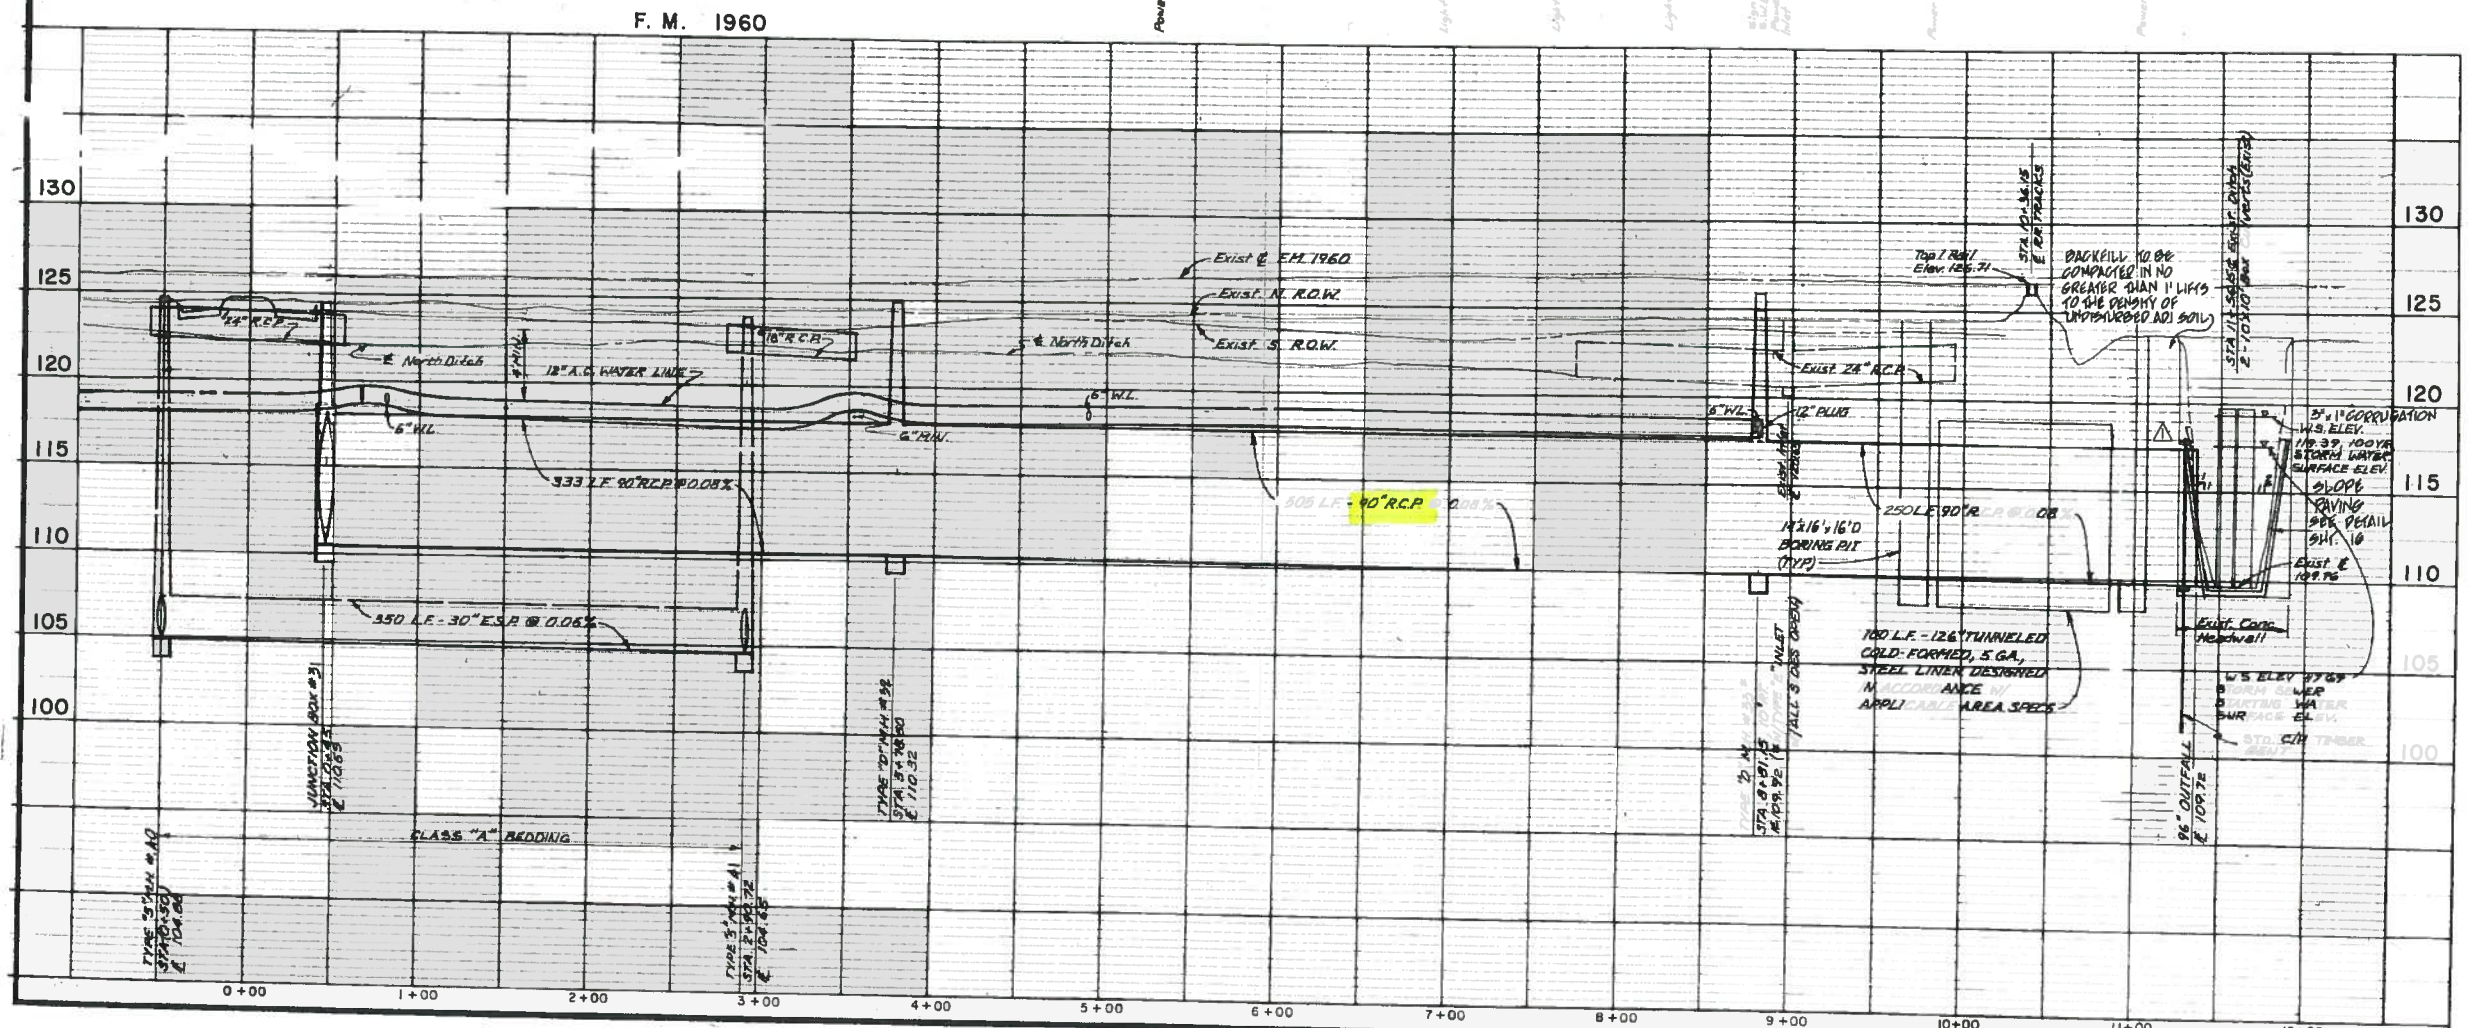

No.	Date	Revision	By
3	2-24-83	ADDED 48" x 48" JUNCTION BOX	
2	4-1-83	ADDED 96" TO 90" RCP	

CHAMPIONS CENTRE DR. & WILLOW CENTRE DR. SECTION ONE
H.C. M.U.D. No. 191
F.M. 1960
STA. (1+00) TO STA. 12+00

Design By: J.W.	Job No: 8-0009	Sheet 11
Drawn By: J.A.M.	Scale: HORZ 1" = 50' VERT 1" = 5'	
Checked By: J.E.M.	Date: SEPT. 1982	of 21

LANDEV ENGINEERS, INC.
1788 SEAMIST DRIVE
Houston, Texas 77008