AF 8549A-2

14" SHEETS/SUM

EQUATION
STA 0+00.00 F.M. 1960
STA 5+30.00 CHAMPIONS CENTRE DR

EQUATION
STA 3+16.73 FM 1960 N. ROW =
STA 0+00.0 WILLOW CENTRE DR 50' LT

BENCH MARK

NATIONAL GEODETIC SURVEY MARKER NO. Y-1216, LOCATED IN CENTER OF HIGHLINE TOWER. (FIRST TOWER N.W. OF F.M. 1960 AND 80' EAST OF R.R. TRACKS)
1979 ADJ EL. 125.41

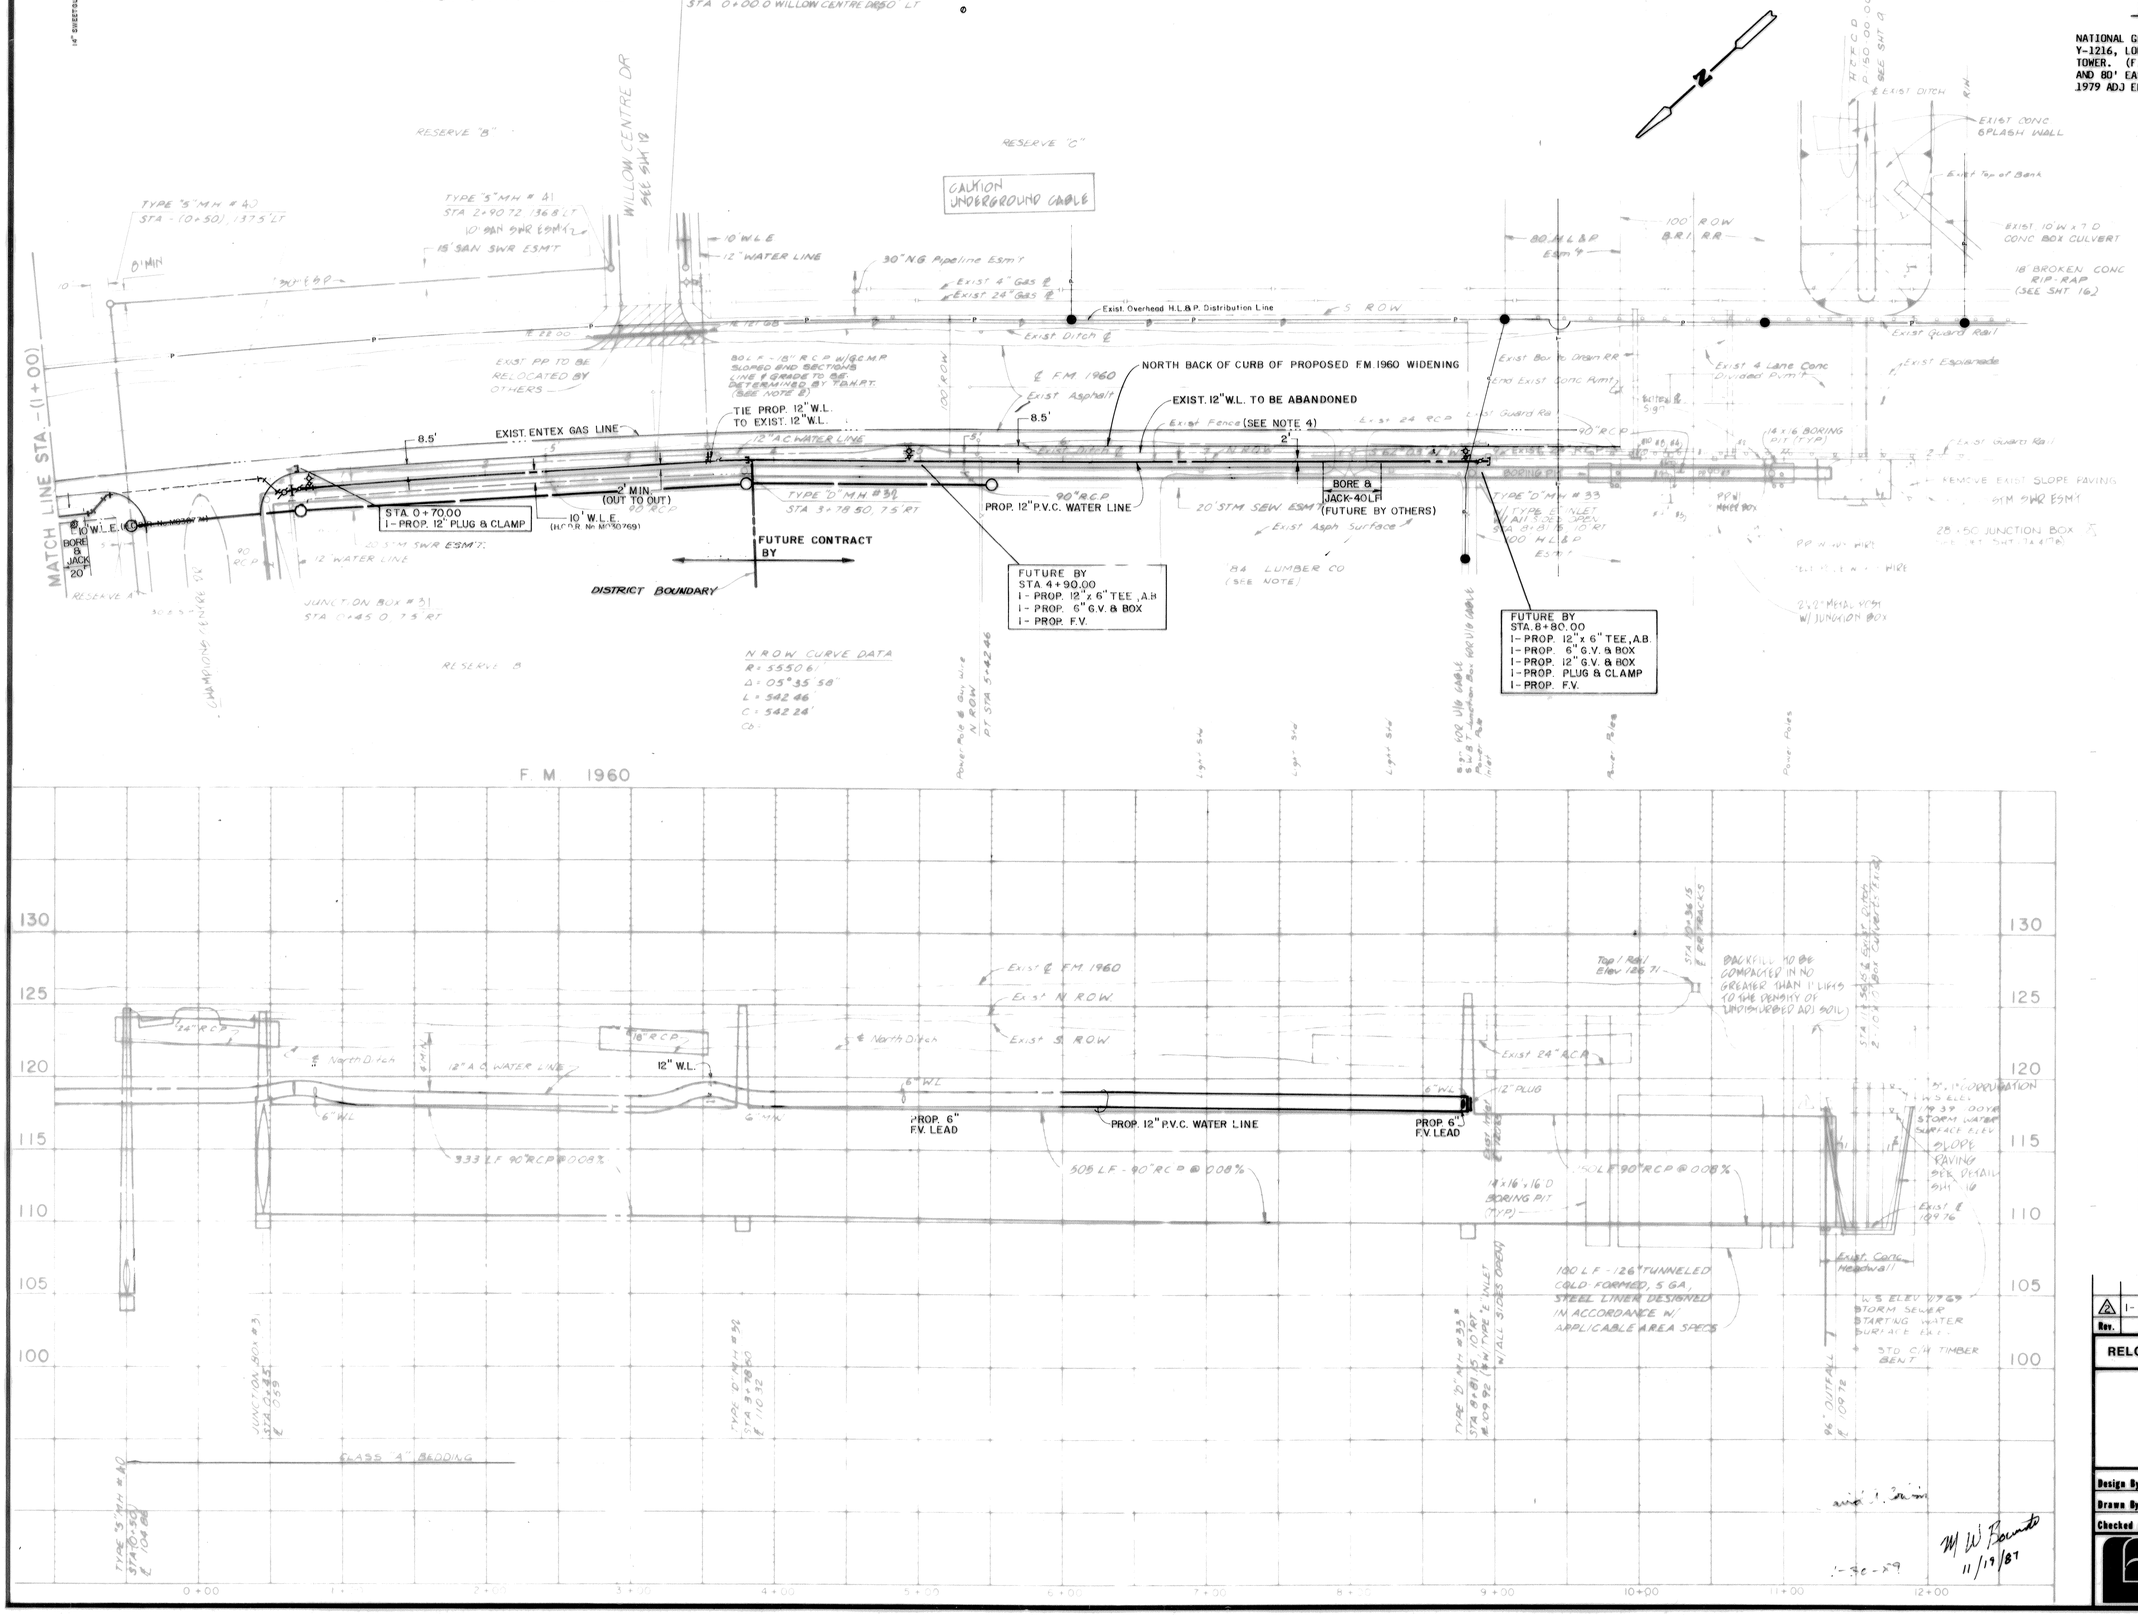

NOTES:

1. CONTRACTOR SHALL VERIFY ALL LOCATIONS & DEPTHS OF ALL UTILITIES, POLES AND PAVEMENTS IN THE FIELD.
2. CONTRACTOR TO NOTIFY MR. STEVE SIMMONS AT 869-4571, EXT. 523 OR JESSE GARCIA AT 580-3031 S.O.H.P.T. 48 HOURS PRIOR TO STARING CONST. IN THE VICINITY OF FM 1960.
3. ALL EXISTING WATER LINE FITTINGS, VALVES, AND FLUSH VALVES ARE TO BE SALVAGED AND REUSED IN CONSTRUCTION OF THE NEW WATER LINE. ALL SALVAGED BUT UNUSED FITTINGS AND VALVES SHALL BE DELIVERED TO THE DISTRICTS WATER PLANT FOR STORAGE.
4. CONTRACTOR SHALL PERFORM BEDDING AND BACK-FILL OPERATIONS VERY CAREFULLY AND IN ACCORDANCE WITH THE SPECIFICATIONS.
5. CONTRACTOR SHALL EXERCISE EXTREME CAUTION WHEN BORING AND JACKING UNDER AND NEAR TREE ROOTS SO AS TO MINIMIZE DISTURBANCE TO THE TREES.
6. CONTRACTOR SHALL VERIFY LOCATION OF SPRINKLER LINES AND HEADS ALONG AND NEAR NORTHSIDE OF 10' WATER LINE EASEMENTS.
7. CONTRACTOR SHALL MAKE CONNECTIONS AT STATIONS -(0+74), 0+64, 0+70, AND 3+85 AT SUCH TIME TO MINIMIZE WATER LINE SERVICE INTERRUPTION.

PRIVATE UTILITY LINES SHOWN

ENTEX, INC.

10-22-87
SOUTHWESTERN BELL TELEPHONE CO.
Valid for One Year Only

11-20-87
HOUSTON LIGHTING & POWER CO.
Approval Only for Crossing Underground Ductlines Unless Noted. Valid for One Year Only

APPROVED FOR CITY OF HOUSTON
DEPARTMENT OF PUBLIC WORKS:

Water Design	Paving
Water Quality	Storm Sewer
Assistant Director - Water Div.	Sanitary Sewer
Bridge Division	
Assistant Director	Director
Date:	

OTHER DEPT'S

Traffic & Transp. Dept.	City Planning Dept.

Rev.	Date	Description	App.
1	1-25-89	ADDED BORE & JACK UNDER TREES, RELOCATED VARIOUS FITTINGS	

RELOCATION OF 12" WATER LINE ON F.M. 1960

HARRIS COUNTY M.U.D. No. 191

F.M. 1960
AS-BUILT
STA. -(1+00) TO STA. 12+00

Design By: J.W.	Job No: 85001-062	Sheet 4
Drawn By: J.G.R.	Scale: HORIZ. 1" = 50' VERT. 1" = 5'	
Checked By: M.W.B.	Date: OCTOBER, 1987	of 5

LANDEV ENGINEERS, INC.
1706 SEAMIST DRIVE
Houston, Texas 77008