

# CONSTRUCTION OF WATER AND SANITARY SEWER EXTENSIONS ALONG DOTSON ROAD


FOR  
**HAMMETT INVESTMENTS, L.P.**  
IN

## HARRIS COUNTY MUNICIPAL UTILITY DISTRICT No. 191


**HARRIS COUNTY, TEXAS**

INDEX OF DRAWINGS

<u>SHEET No.</u>	<u>TITLE</u>
1.	COVER
2.	CONSTRUCTION NOTES
3.	WATER & SANITARY SEWER GENERAL LAYOUTS
<u>PLAN &amp; PROFILE</u>	
4.	BASELINE "A" DOTSON ROAD STA 0+00 TO STA 3+00
5.	BASELINE "A" DOTSON ROAD STA 5+00 TO STA 8+00
6.	BASELINE "B" STA 7+00 TO STA 11+00
7.	BASELINE "B" STA 11+00 TO STA 12+50
<u>DETAILS</u>	
8.	STORM WATER POLLUTION PREVENTION PLAN
9.	H.C. S.W.P.P. STANDARD DETAILS
10.	TRAFFIC CONTROL PLAN
11.	WATER & SANITARY SEWER STANDARD DETAILS
12.	BARRICADE STANDARDS
13.	EXPRESS REVIEW SHEET

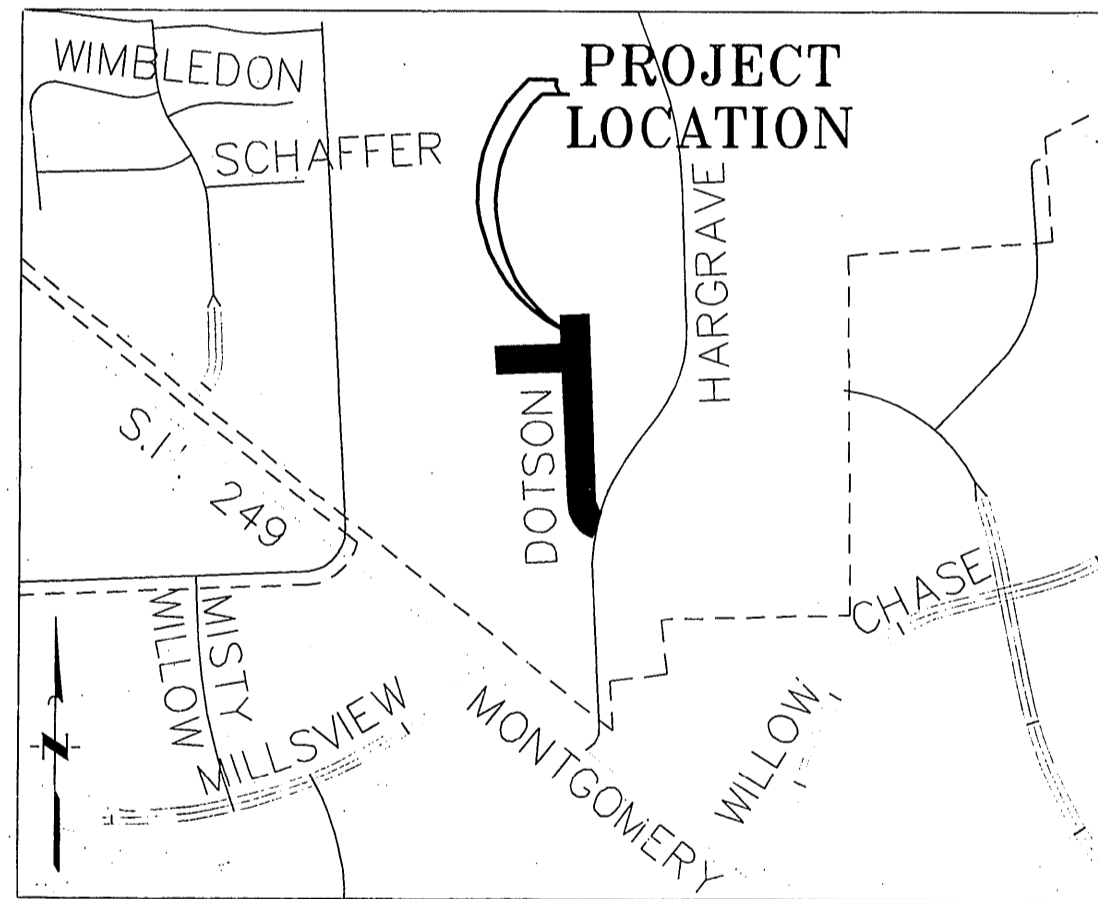

AREA MAP

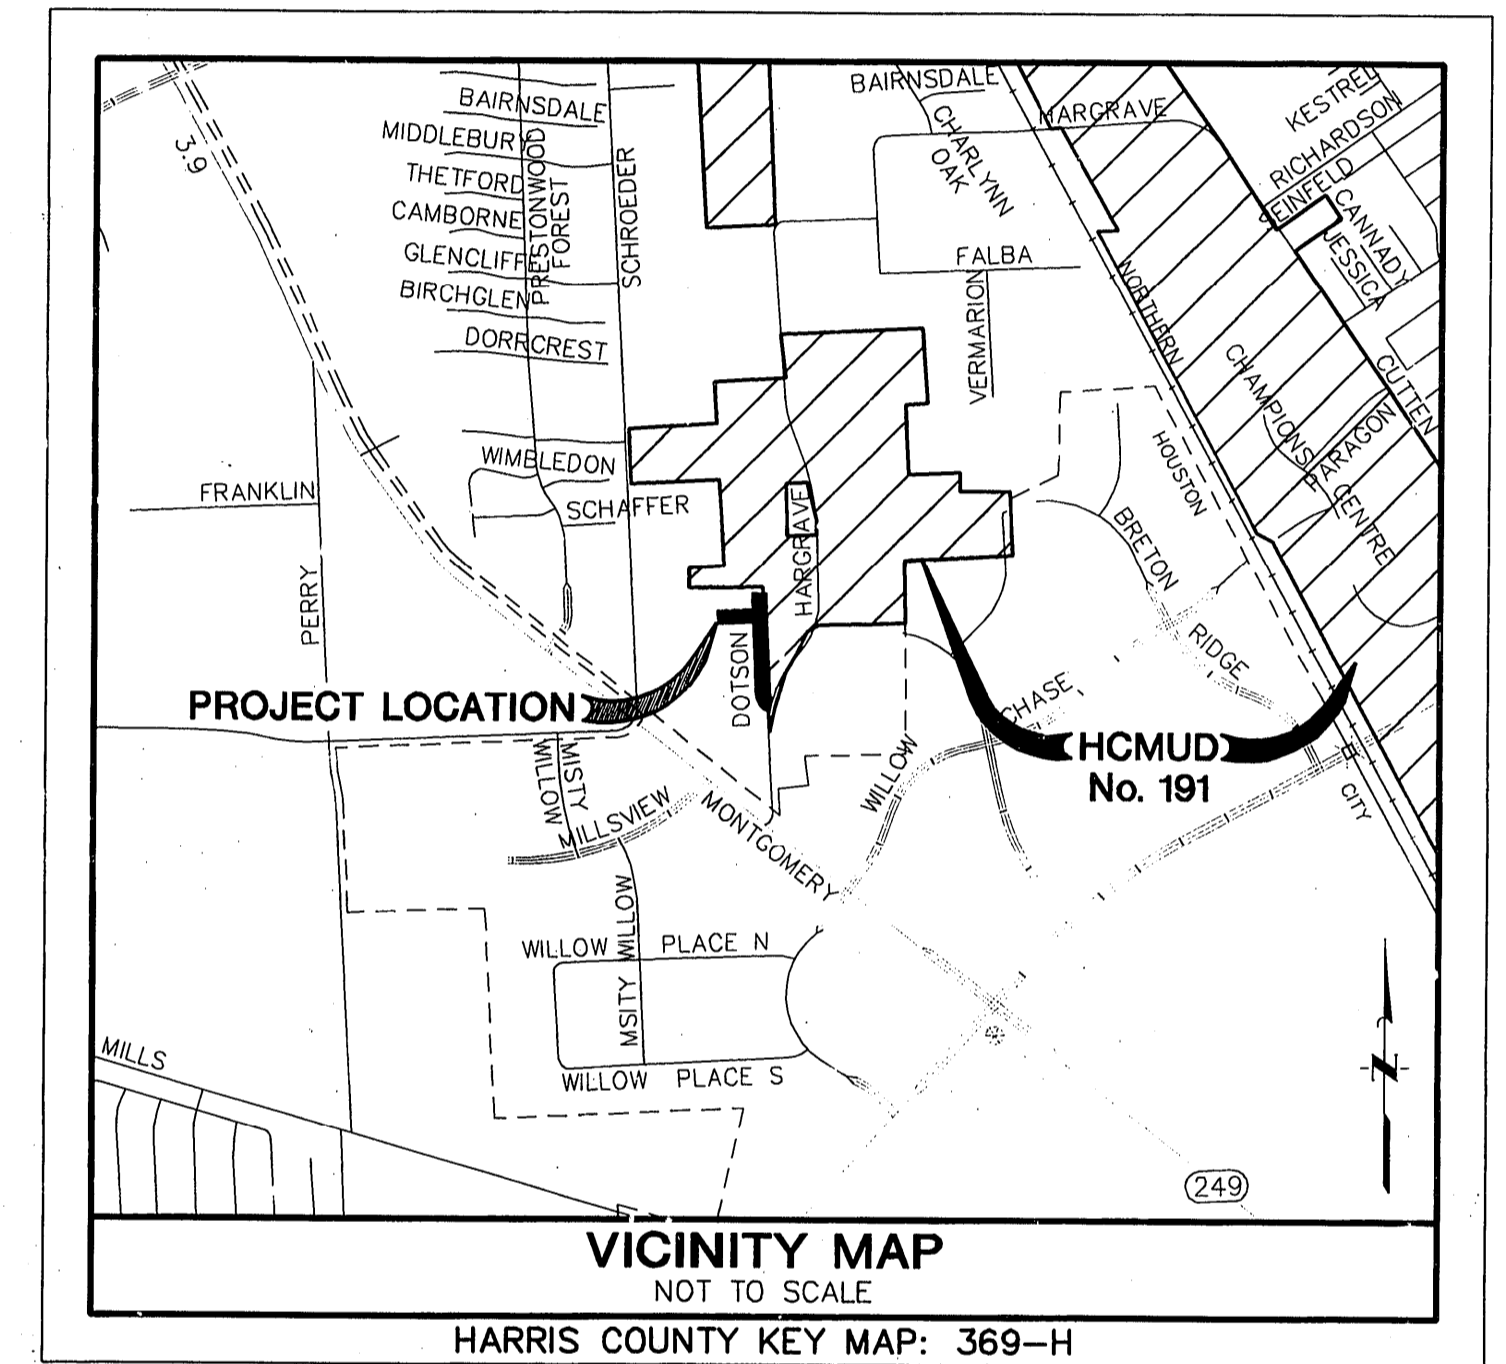

**VICINITY MAP**  
NOT TO SCALE  
HARRIS COUNTY KEY MAP: 369-H  
FEMA MAP No. 48201C0435L

"Prior to the construction of these facilities within or by the District, the District or its Engineer will give written notice by the Registered or Certified Mail to the Director of Public Works and Engineering stating the date such construction will be commenced."

APRIL 2007

**JC JONES & CARTER, INC.**  
ENGINEERS • PLANNERS • SURVEYORS  
6335 Gullfion Dr., Suite 100 Houston, Texas 77081 (713) 777-5337

**RECORD  
DRAWING**

ILMS No. 07013900  
C.O.H. LOG No. 07-0193

SURVEYED BY: _____ FB NO.: _____	
NOTE: CITY SIGNATURES VALID FOR ONE YEAR ONLY AFTER DATE OF SIGNATURES	
<b>CITY OF HOUSTON</b>	
DEPARTMENT OF PUBLIC WORKS AND ENGINEERING	
WATER 4/11/07	TRAFFIC & TRANSPORTATION
WASTEWATER 4/12/07	STORM WATER QUALITY
STORM	FACILITIES
STREET & BRIDGE	
CITY ENGINEER	
FOR CITY OF HOUSTON USE ONLY	
SHEET No: 1 OF 13	

WATER AND SANITARY SEWER EXTENSIONS ALONG DOTSON ROAD FOR HAMMETT INVESTMENTS, L.P.  
IN HARRIS COUNTY MUNICIPAL UTILITY DISTRICT No. 191

**JC JONES & CARTER, INC.**  
ENGINEERS • PLANNERS • SURVEYORS  
Houston, Texas